

MICROFILMED

268



267

GREENVILLE CO. S.C.
AUG 1 8 50 AM '84
DONNIE S. TAMKERSLEY
R.M.C.

272

273

274

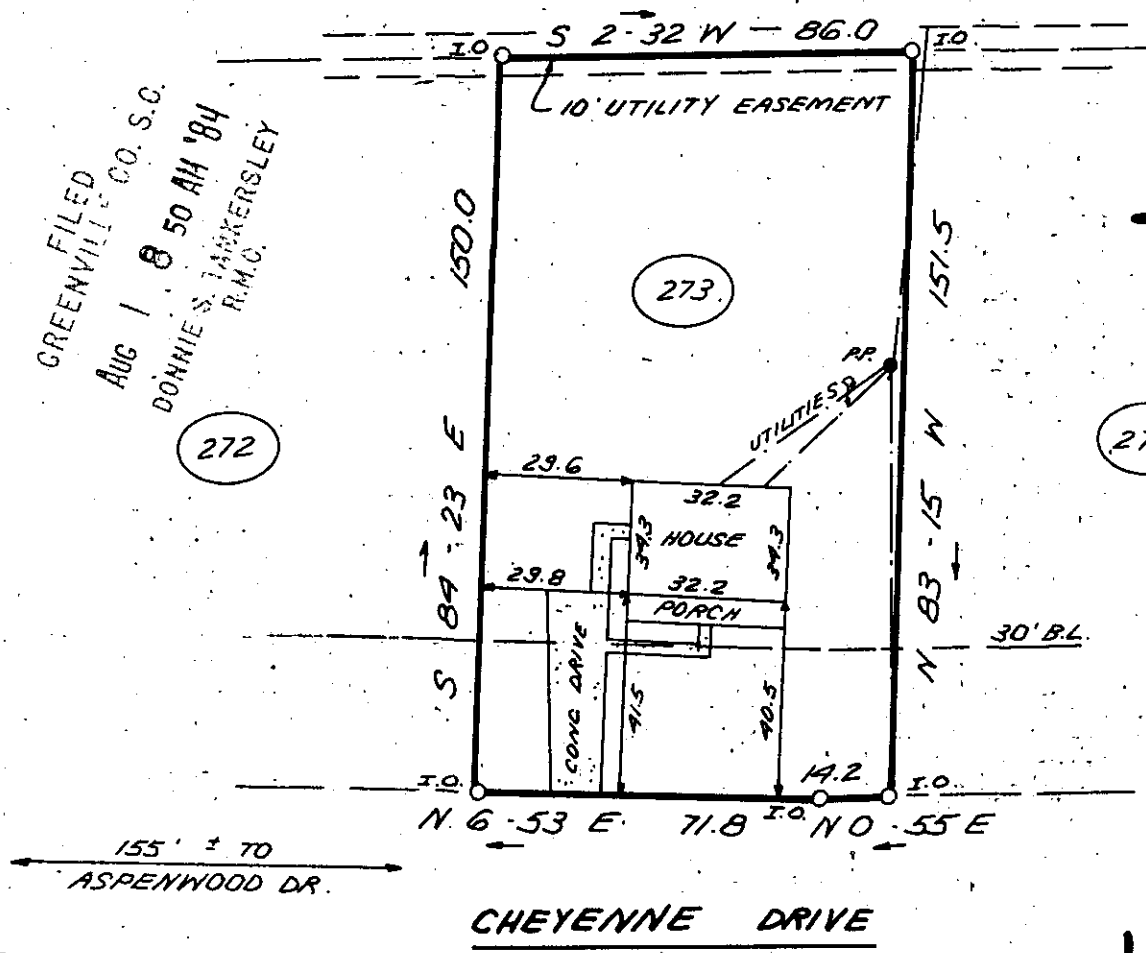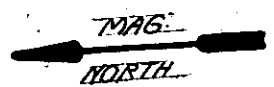

3548 ✓


10V-65

NOTE: 5' UTILITY & DRAINAGE EASEMENTS ALONG ALL SIDE & REAR LOT LINES UNLESS OTHERWISE SHOWN.



AUG 1 1984

THIS IS TO CERTIFY THAT THE PROPERTY SHOWN ON THIS PLAT WAS SURVEYED UNDER MY DIRECT SUPERVISION. PROPERTY LINES AND IMPROVEMENTS SHOWN ARE LOCATED CORRECTLY AND THAT NO VISIBLE ENCROACHMENTS EXIST UNLESS OTHERWISE SHOWN. THIS PROPERTY IS NOT LOCATED IN A DESIGNATED FLOOD HAZARD AREA.

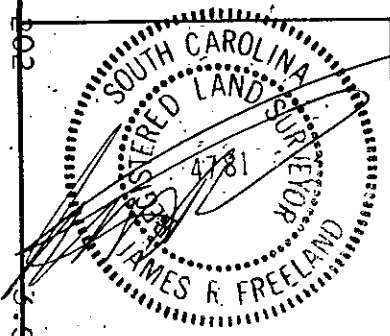

STATE OF SOUTH CAROLINA
GREENVILLE COUNTY

FREELAND & ASSOCIATES
Engineers • Land Surveyors
318 WEST STONE AVENUE.
GREENVILLE, S.C.
(803) 271-4924

WESTWOOD
SEC. 3; LOT 273
PROPERTY OF
DAVID L. WILSON
BETH M. WILSON

PLAT BOOK	4N @ 30
DEED BOOK	1147 @ 289
TAX MAP	574.8 - 1-94
PARTY CHIEF	J.C.
DRAWN	K.E.G.
DATE	JULY 26, 1984
DWG. NO.	11,543

PLS: JAMES R. FREELAND
NO: 4781