

25

24

23

MICROFILMED

FILED  
GREENVILLE  
N 25 05' 00" E

229.26

I.O.

AUG 6 10 58 AM '84

DONNIE S. TANKERSLEY  
R.M.C.

21




20

22

N 64-08 W  
185.0

S 64-08 E  
190.0

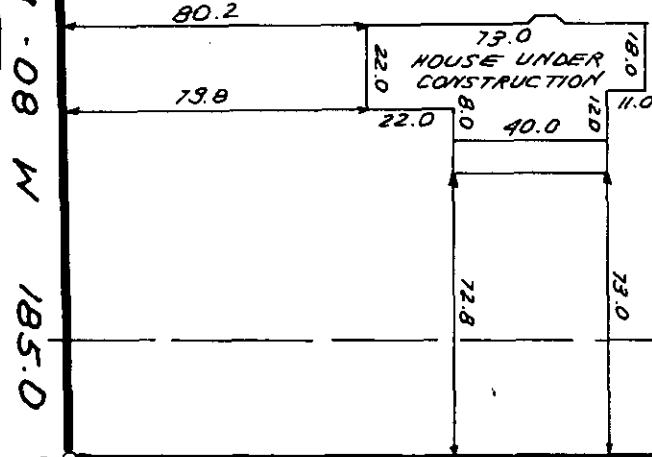

S 27-06 W

229.32

I.O.

OAK MEADOWS DR.

205.91 ± TO  
SPRING MEADOW DR.


NOTE: 5' DRAINAGE & UTILITY  
EASEMENT ALONG EACH  
SIDE OF ALL SIDE & REAR  
LOT LINES.



4055

10-V-90

THIS IS TO CERTIFY THAT THE PROPERTY SHOWN ON THIS PLAT WAS SURVEYED UNDER MY DIRECT SUPERVISION. PROPERTY LINES AND IMPROVEMENTS SHOWN ARE LOCATED CORRECTLY AND THAT NO VISIBLE ENCROACHMENTS EXIST UNLESS OTHERWISE SHOWN. THIS PROPERTY IS NOT LOCATED IN A DESIGNATED FLOOD HAZARD AREA.

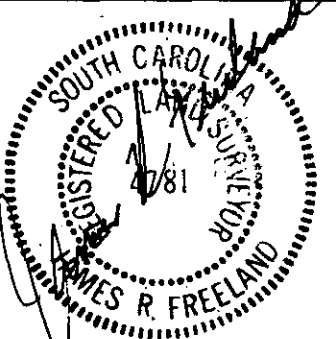

STATE OF SOUTH CAROLINA  
GREENVILLE COUNTY

FREELAND & ASSOCIATES  
Engineers • Land Surveyors  
318 WEST STONE AVENUE.  
GREENVILLE, S.C.  
(803) 271-4924

OAK MEADOWS  
LOT 21  
PROPERTY OF

EASTERN DISTRIBUTION, INC.

PLAT BOOK	3W @ 57
DEED BOOK	
TAX MAP	
PARTY CHIEF	L. T.
DRAWN	K.E.G.
DATE	AUG 2, 1984
DWG. NO.	11585

PLS: JAMES R. FREELAND  
NO: 4781