MICROFILMED

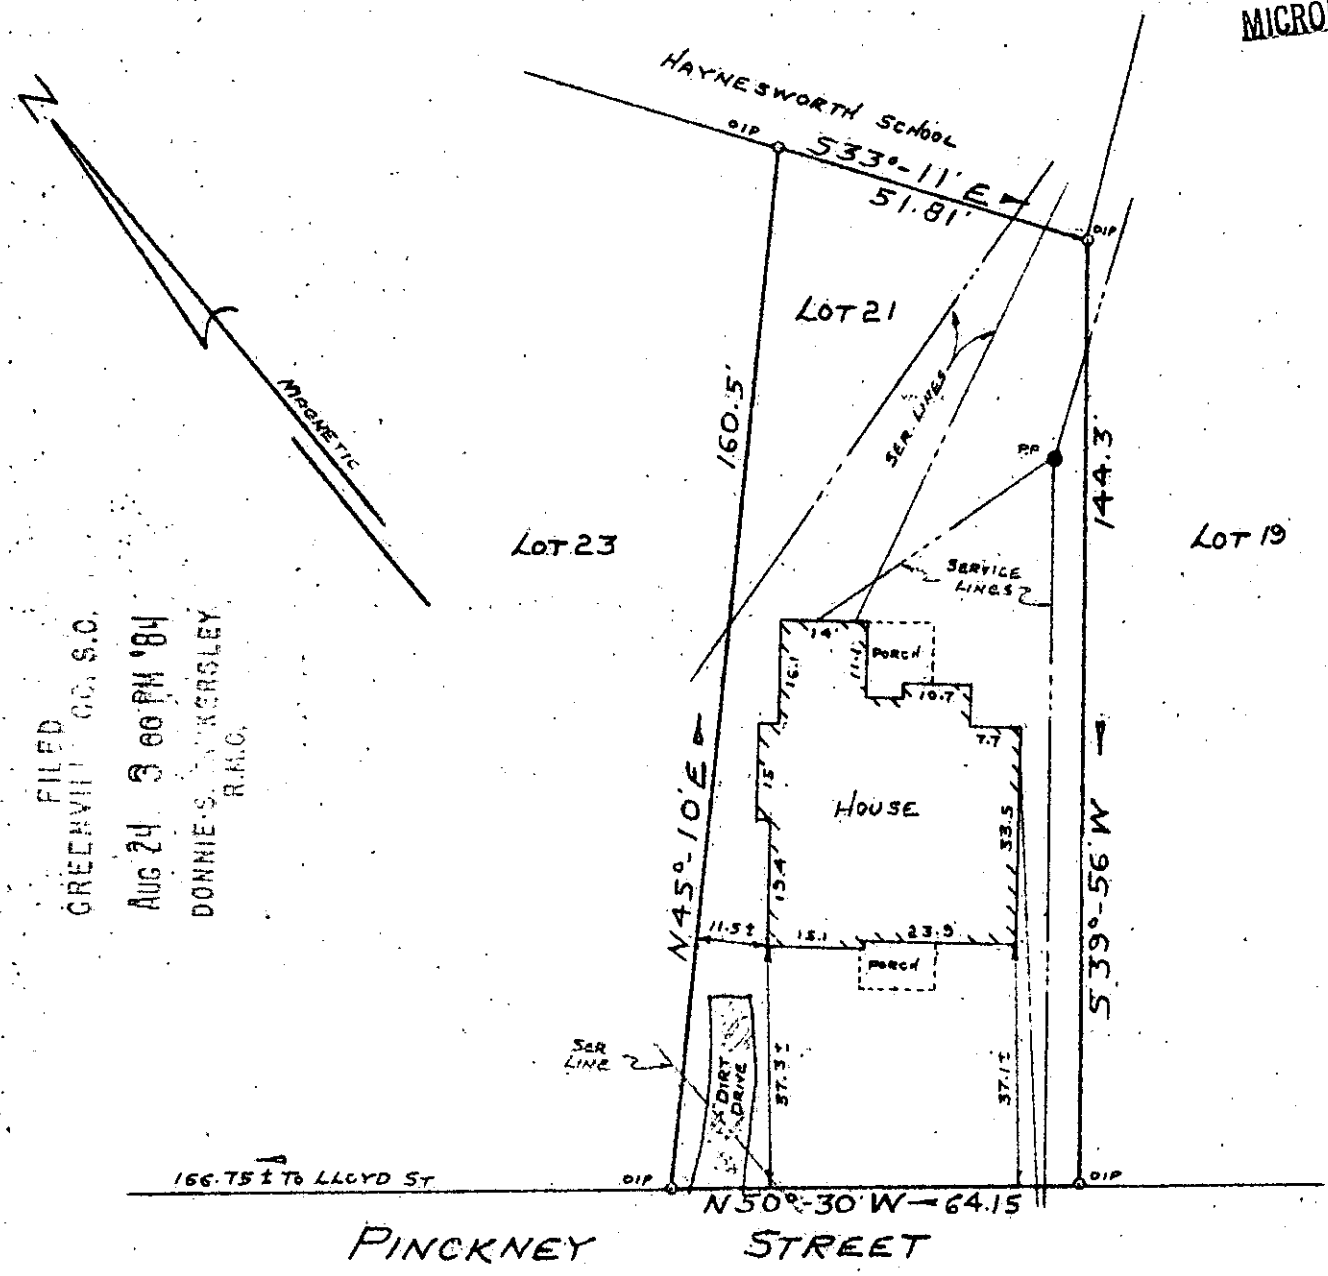

FILED
GREENVILLE CO. S.C.
AUG 24 3 00 PM '84
DONNIE S. TANKERSLEY
R.M.C.

PROPERTY OF

CHRISTOPHER STALEY BURRITT

GREENVILLE, GREENVILLE COUNTY, SOUTH CAROLINA

AUG 22, 1984 SCALE 1" = 30'

This is to certify that on August 22, 1984, I surveyed the property shown on this plat known as Lot No. 21 of W. P. McBee Property as recorded in the RMC Office for Greenville County in Plat Book A at Page 83, also known as Property of Jimmy J. Tharpe as recorded in Plat Book 8-G at Page 28, and that the property lines, walls and buildings are as shown hereon, and that the building located on said lot does not project nor encroach on adjacent streets or property, and that no adjacent walls or buildings project nor encroach on said lot, and that no utility lines cross this lot except as may be shown hereon. The degree of accuracy is 1/6,000.

6089

NOTE: This property is not located within a flood hazard area.

Surveyed by: Richard D. Wooten, Jr.
Greenville, South Carolina

SOUTH CAROLINA REGISTERED LAND SURVEYOR

S. C. R. L. S. No. 4678

10-W-49

300 8 31 801