
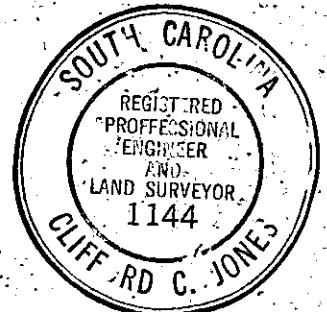


FILED
 GREENVILLE CO. S.C.
 AUG 30 3 00 PM '84
 DONNIE S. HARRERSLEY
 R.M.C.

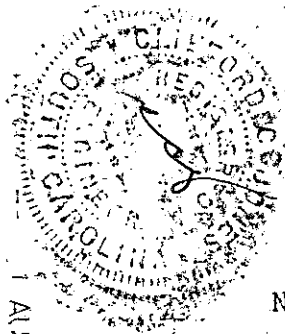

NOTE. THIS LOT DOES NOT LIE IN A FLOOD PLANE.

10-W-24 6723

PROPERTY OF
 ROBERT D TERRELL &
 MARY I TERRELL
 GREENVILLE S. C.

This is to certify that on the 14 day of OCT
 surveyed the property shown on this
 plat of 1984
 LOT 2, WILWOOD ACRES
 of the R.M.C. Office for Greenville County,
 S. C., and that the property lines, walls and
 buildings are as shown hereon; that the buildings
 located on said lot do not encroach or project on
 adjacent streets or property; and that no adjacent
 buildings or walls encroach or project on said
 premises, and that no utility lines cross this
 property.

SCALE 1"=50' MAY 28 79
 REVISED 8-27-1984
 LINE BETWEEN LOTS 1 & 2

Reg. Engineer No. 1144 S.C.

1 AUG 30 1984