


Note: Improvements on this lot are not in a flood hazard area.

FILED
GREENVILLE CO. S.C.
AUG 31 12 25 PM '84
DONNIE S. WILKINSLEY
REGISTER

AUG 31 1984
6875

10-W-83

PROPERTY OF
JAMES E. SPEED & DEBRA J. SPEED
1414 PIEDMONT GREENVILLE COUNTY, S.C.
SCALE: 1:200 AUG 1984

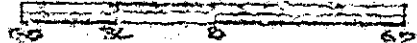

This is to certify that on the 21st day of August, 1984, I surveyed the property shown on this plat, being known as lot 27 on plot of GOLDEN GROVE SECTION 1 and recorded in the 1983 Office Greenville County, S. C., in Plat Book "4 - B" at Page 4; and that the property lines, walls and buildings are as shown hereon, and that the walls and buildings located on said lot do not encroach or project on adjacent street or property, and that no adjacent walls or buildings encroach or project on said premises, and no power lines cross this property except as shown hereon.

Recordable Plat *R. B. Brubaker*

CAROLINA SURVEYING CO. R. B. Brubaker, Inc. 1000 AVENUE BRUCE

300 3 21A01