


Note:  
Improvements  
on this lot are  
not in a flood  
hazard area.

2685 MAXEY AVE (DAVIS ST)  
WATER & SEWER IN ST 2/1  
PROPERTY OF  
WAYNE W. ELLER  
NEAR GREENVILLE, S.C.  
SCALE 1" = 40' 16 AUG 1984

SEP 7 1984

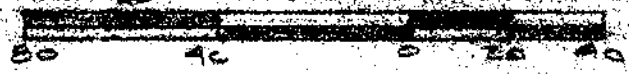

This is to certify that on the 16th day of August, 1984, I surveyed the property shown on this plat, being known as PROPERTY OF WAYNE W. ELLER and recorded in the RMC Office Greenville County, S. C., in Plat Book \_\_\_\_\_ at Page \_\_\_\_\_; and that the property lines, walls and buildings are as shown hereon, and that the walls and buildings located on said lot do not encroach or project on adjacent street or property, and that no adjacent walls or buildings encroach or project on said premises, and no power lines cross this property except as shown hereon.

10W-96

CAROLINA SURVEYING CO.  
112 Mainly St.  
Greenville, S. C.

SOUTH CAROLINA  
REGISTERED  
R. B. [Signature]  
AUG 1984

Recordable Plat

SEP 7 84 1125

31001