
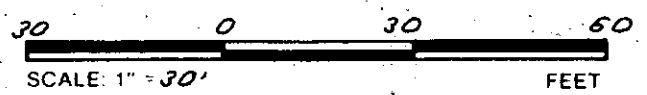
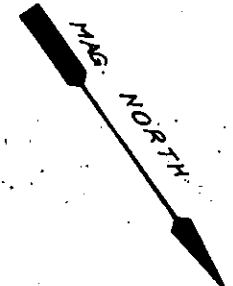


FILED
 GREENVILLE CO. S. C.
 SEP 12 11 32 AM '84
 DONNIE S. TARKERSLEY
 R.M.C.

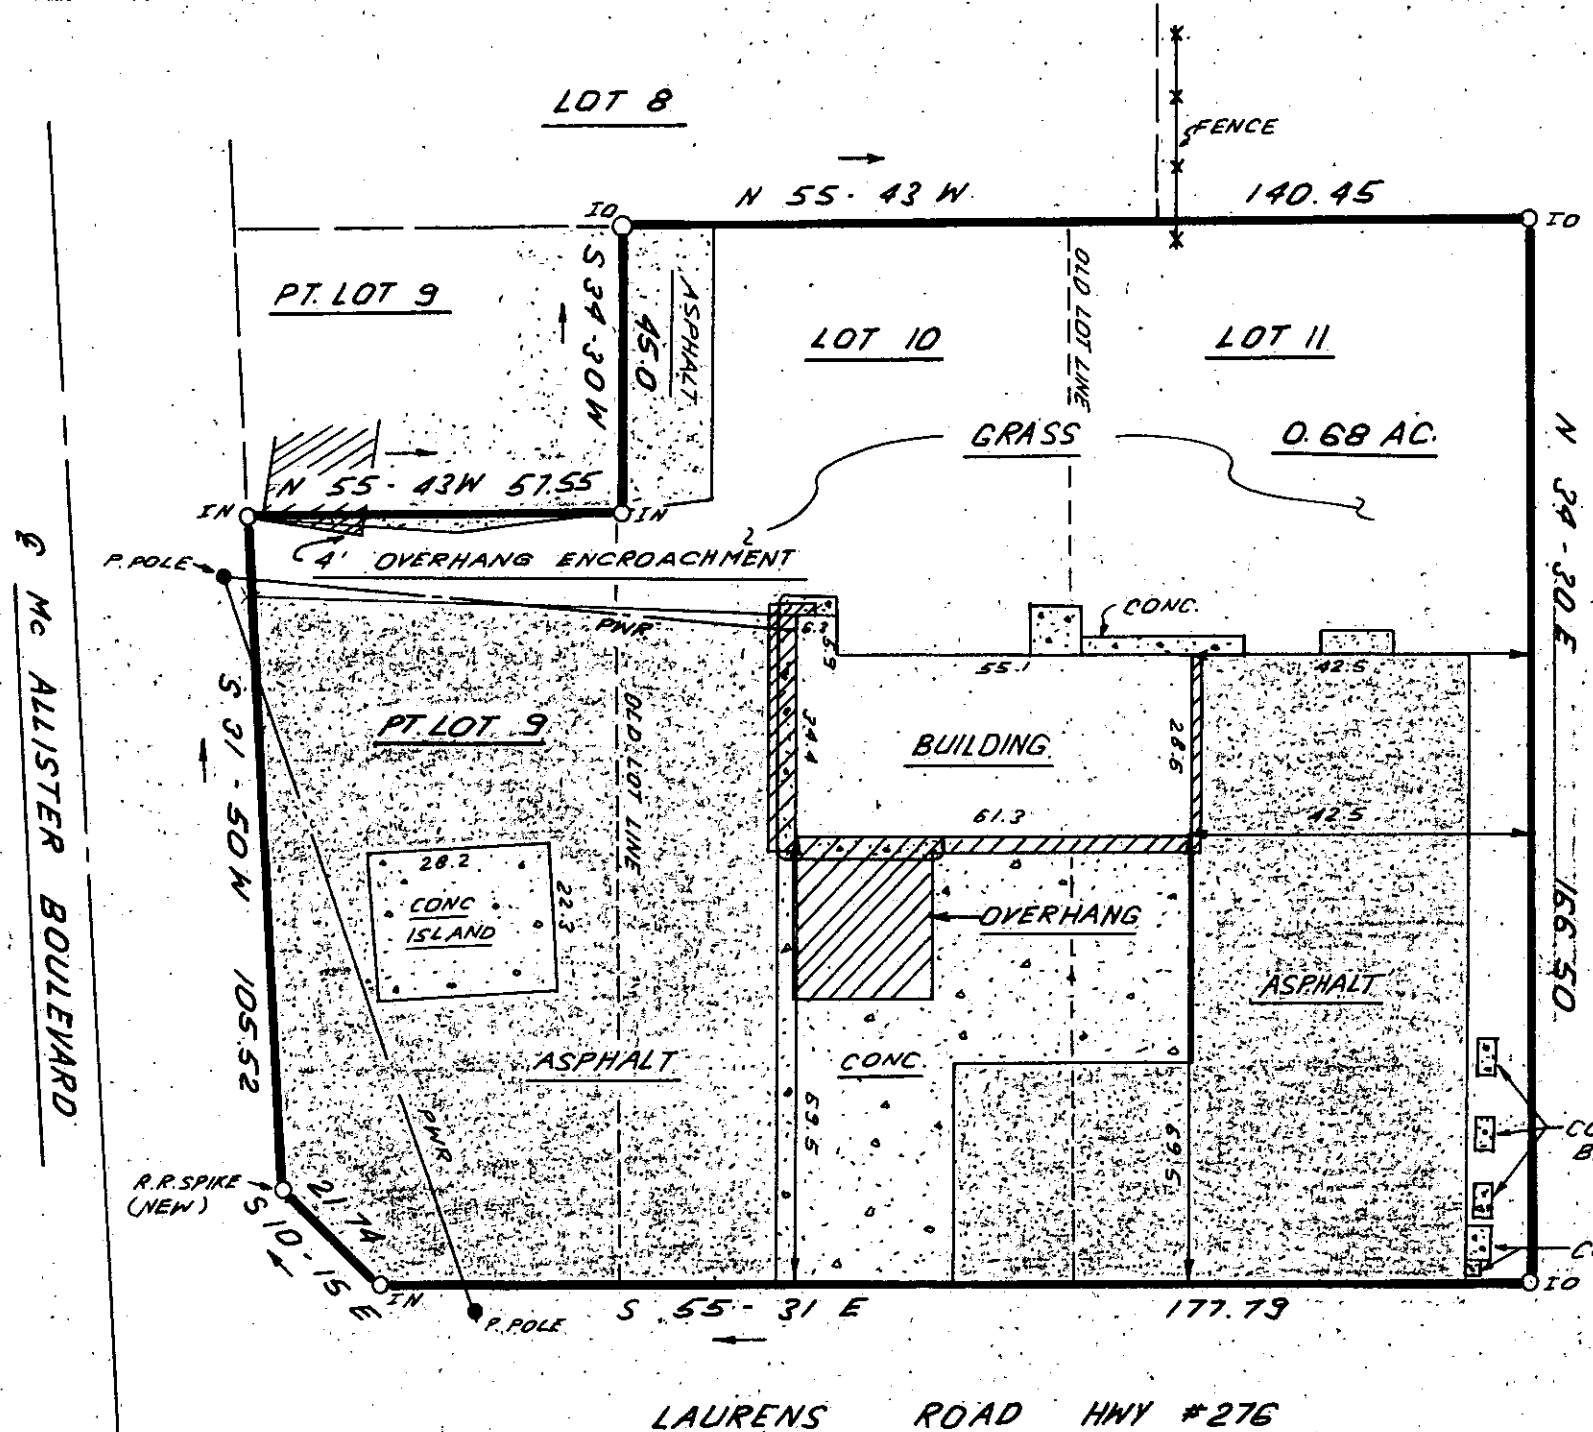

THIS IS TO CERTIFY THAT THE PROPERTY SHOWN ON THIS PLAT WAS SURVEYED UNDER MY DIRECT SUPERVISION. PROPERTY LINES AND IMPROVEMENTS SHOWN ARE LOCATED CORRECTLY AND THAT NO VISIBLE ENCROACHMENTS EXIST UNLESS OTHERWISE SHOWN. THIS PROPERTY IS NOT LOCATED IN A DESIGNATED FLOOD HAZARD AREA.

SEP 12 1984

10X-13

<p>REGISTERED LAND SURVEYOR 4781 JAMES R. FREELAND RLS: JAMES R. FREELAND NO: 4781</p>	<p>STATE OF SOUTH CAROLINA GREENVILLE COUNTY</p>	<p>FREELAND & ASSOCIATES Engineers • Land Surveyors 318 WEST STONE AVENUE. GREENVILLE, S.C. (803) 271-4924</p>
	<p><u>E.G. WEBSTER PROP.</u> <u>PT. LOT 9, LOT 10 & LOT 11</u> <u>PROPERTY OF</u> <u>KENNETH C. COSGROVE</u></p>	<p>PLAT BOOK <u>K-39</u> DEED BOOK <u>1152-989</u> TAX MAP <u>199.1-1-8</u> PARTY CHIEF <u>L.T.</u> DRAWN <u>I.R.</u> DATE <u>8-3-84</u> DWG. NO. <u>11587</u></p>

THE PRINT MACHINE, INC. N41289

MICROFILMED