



FILED  
GREENVILLE CO. S.C.  
OCT 5 12 47 PM '84  
DONNIE S. TANKERSLEY  
R.M.C.

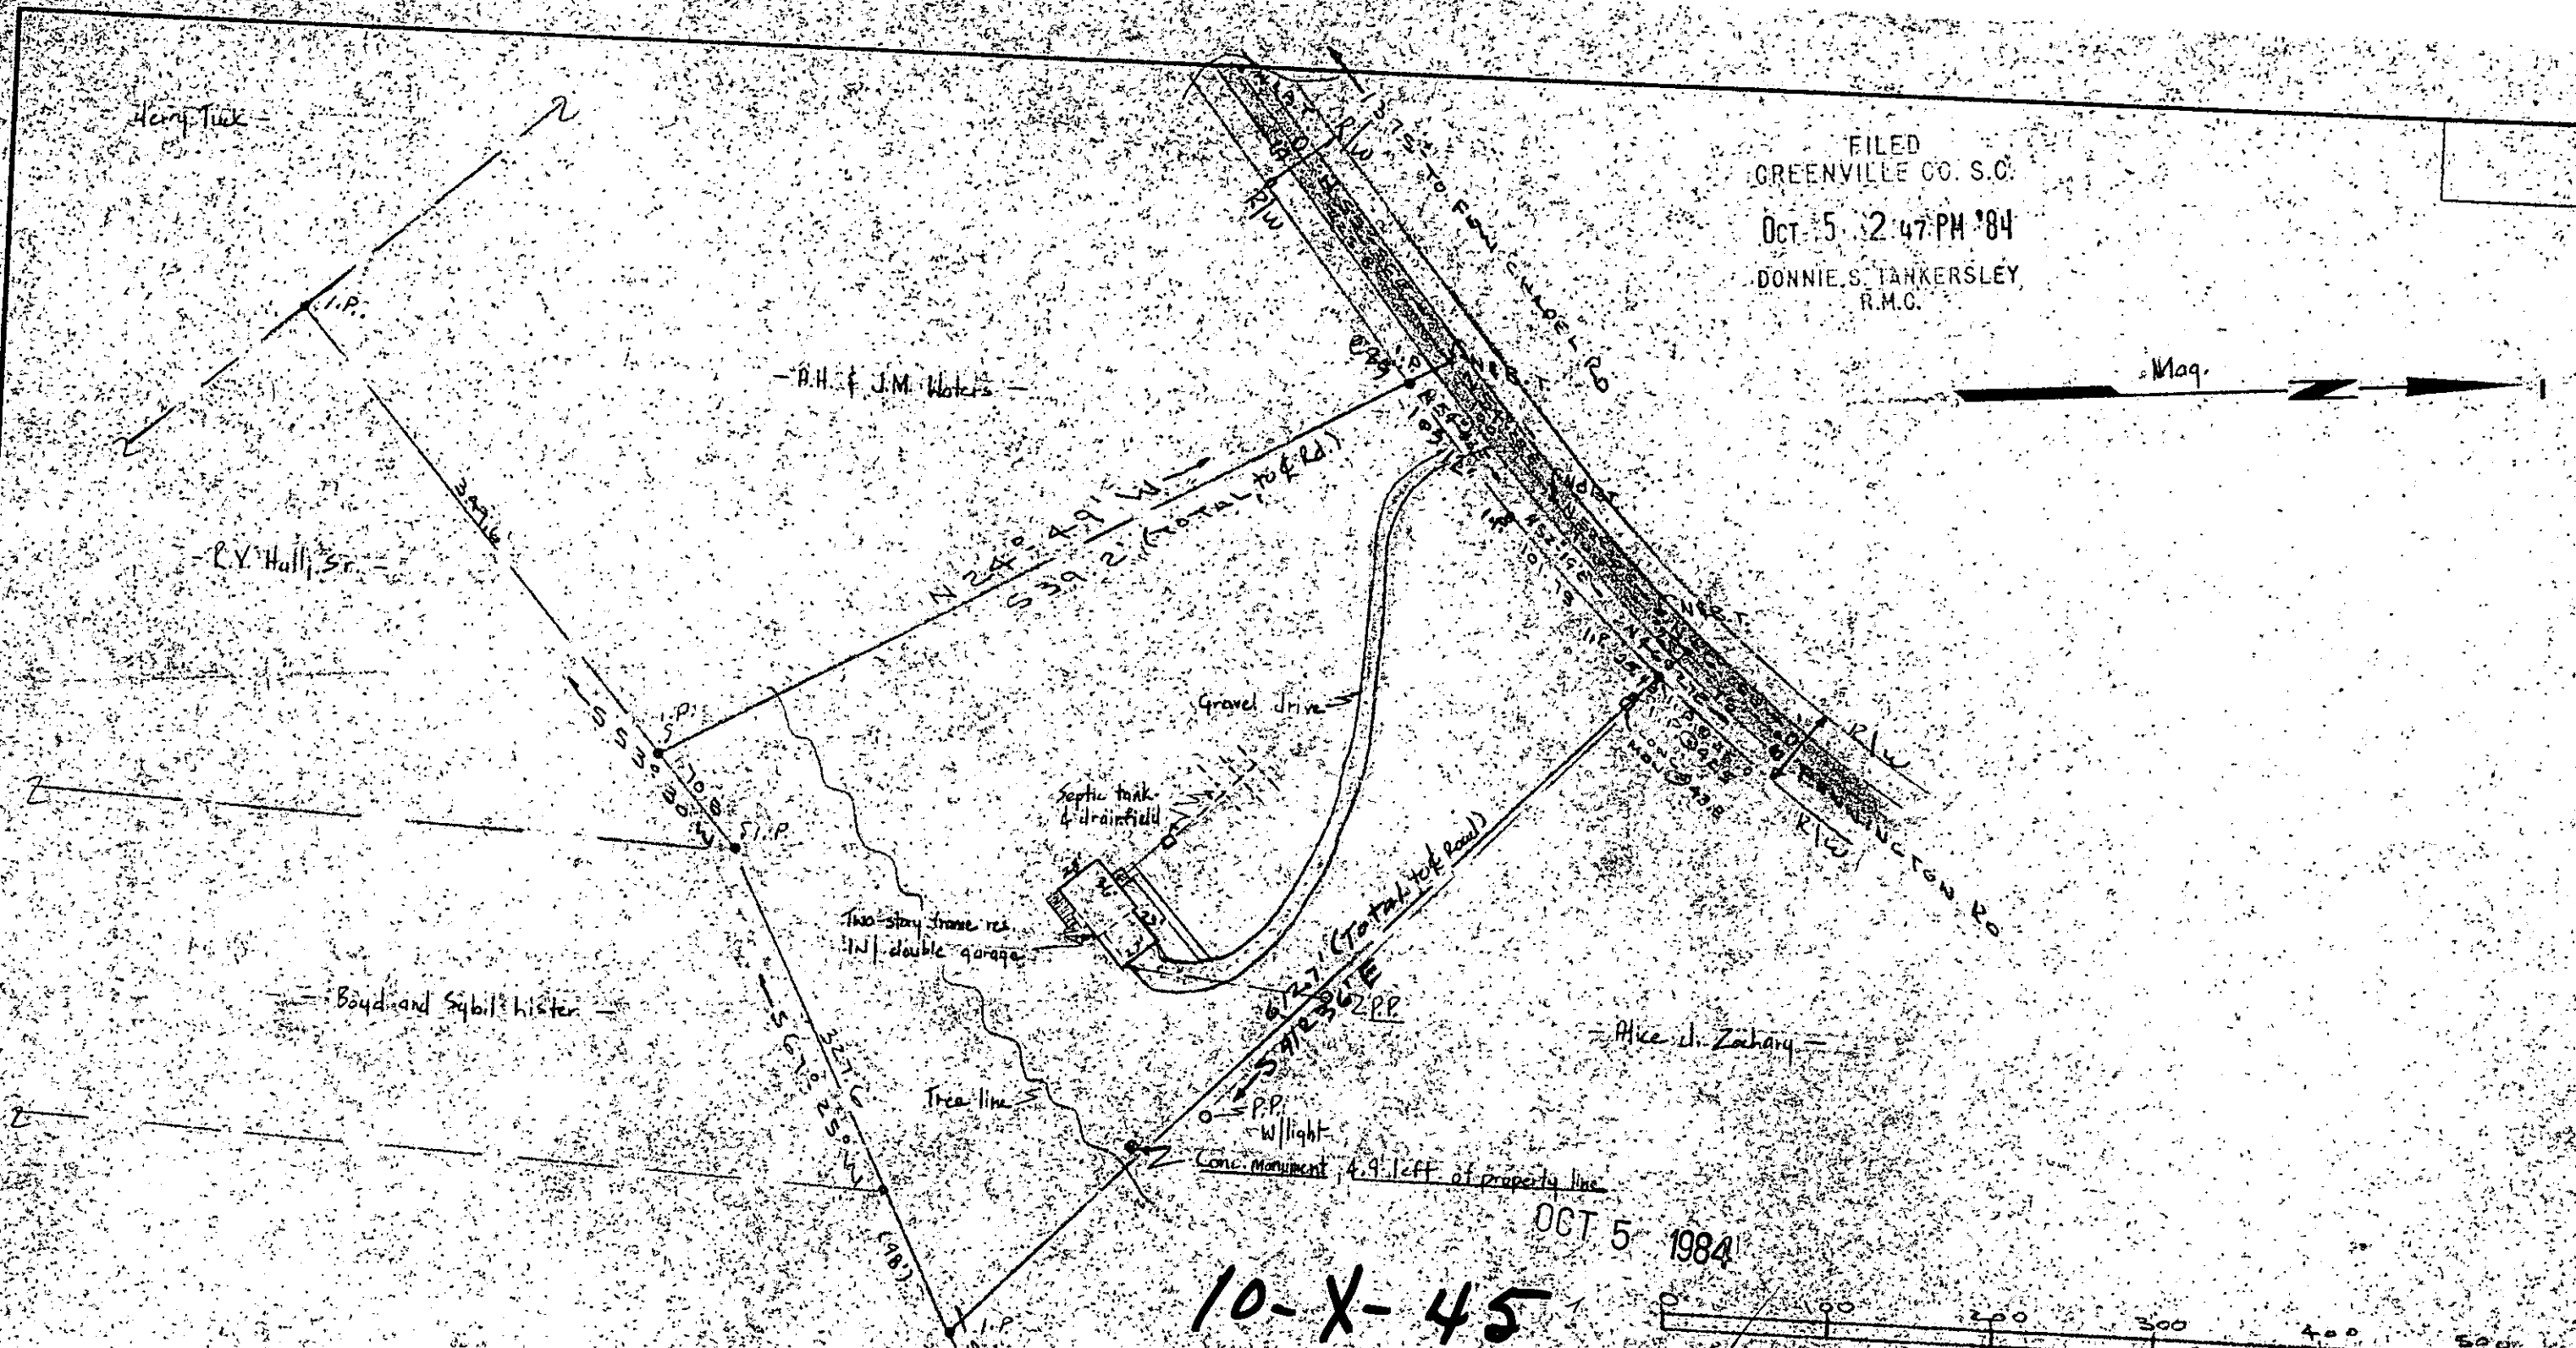

10-X-45

OCT 5 1984

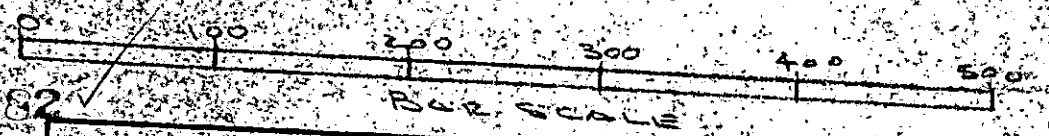

I CERTIFY THE ABOVE TRACT  
HAS BEEN SURVEYED & IS AS  
SHOWN TO THE BEST OF MY  
KNOWLEDGE AND EXPERIENCE  
DATE 10/5/84

*[Handwritten signature]*  
10582

PROPERTY OF <b>DAVID C &amp; DONNA L. JONES</b>		
SCALE 1"=100'	APPROVED BY	DRAWN BY K.T.G.
DATE 10-5-84		
3.82 Acres on Pennington Rd., O'Neal Township Greenville County, South Carolina		
Required 9-12-84 to show location of house & appurtenances & ALL ISSUANCE		
DRAWING NUMBER		6915 OCT