MICROFILMED

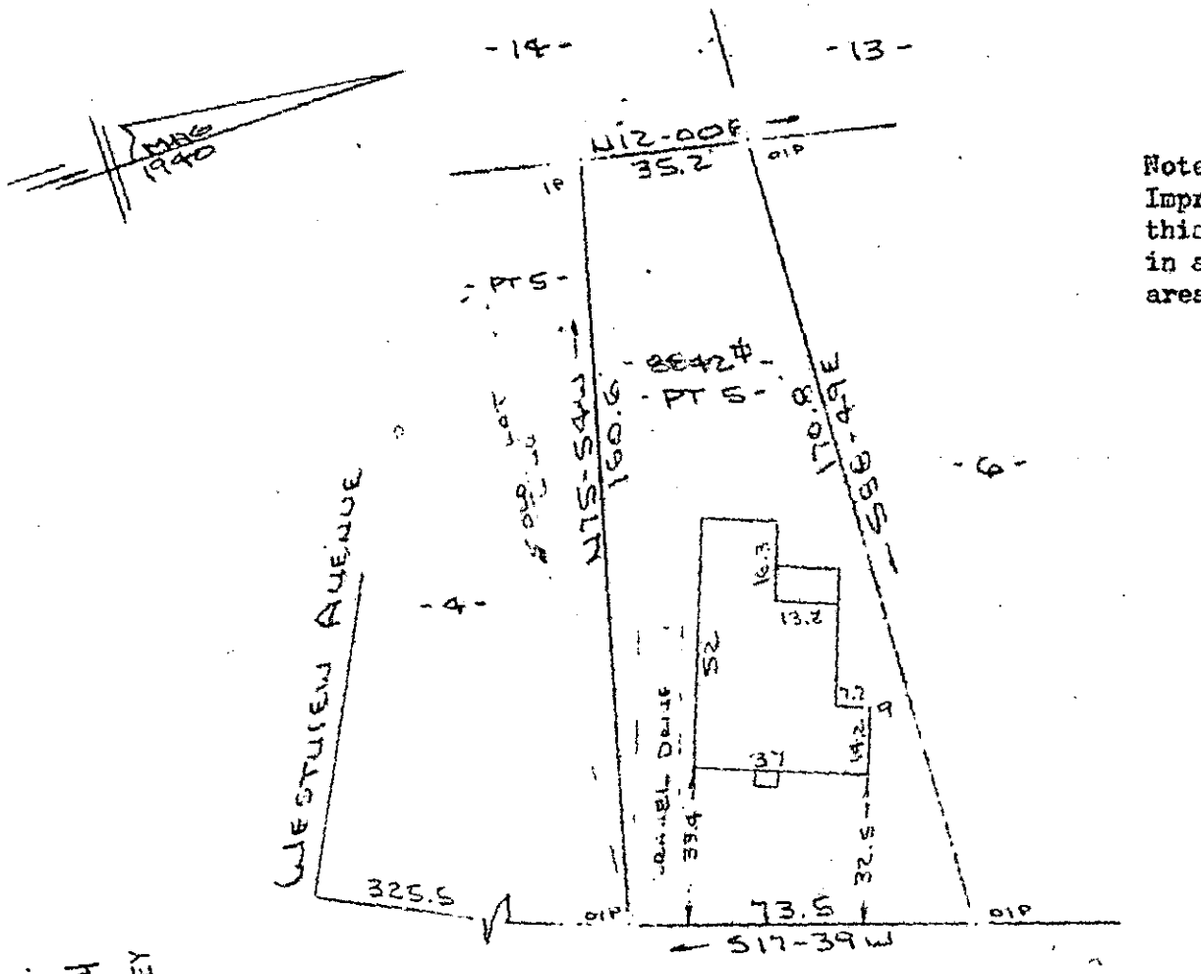

Note:
Improvements on this lot are not in a flood hazard area.

PROPERTY OF
C. W. WINCHESTER, JR.
GREENVILLE COUNTY, GREENVILLE, S.C.
SCALE: 1"=40' 13 SEPT 1984

40 20 0 40

FILED
GREENVILLE CO. S.C.
SEP 20 3 55 PM '84
DONNIE S. TANKERSLEY
R.M.C.

This is to certify that on the 13th day of September, 1984, I surveyed the property shown on this plat, being known as part of lot 5 on plat of PARVALE SECTION " A " and recorded in the RMC Office Greenville County, S. C., in Plat Book " K " at Page 52 and also being known as PROPERTY OF C. W. WINCHESTER, JR. and recorded in the RMC Office Greenville County, S. C., in Plat Book " " at Page ; and that the property lines, walls and buildings are as shown hereon, and that the walls and buildings located on said lot do not encroach or project on adjacent street or property, and that no adjacent walls or buildings encroach or project on said premises, and no power lines cross this property except as shown hereon.

10-1-35 8934

SEP 20 1984

R. B. Bruce, RLS # 1952

CAROLINA SURVEYING CO.
112 Manly St.
Greenville, S. C.

Recordable Plat

2 SE20 84 578

3.00CI

281/14

179-3-5