

MICROFILMED

FILED
GREENVILLE CO. S.C.

SEP 24 3 26 PM '84

DONNIE S. TANKERSLEY
R.M.C.




38

37

39

36

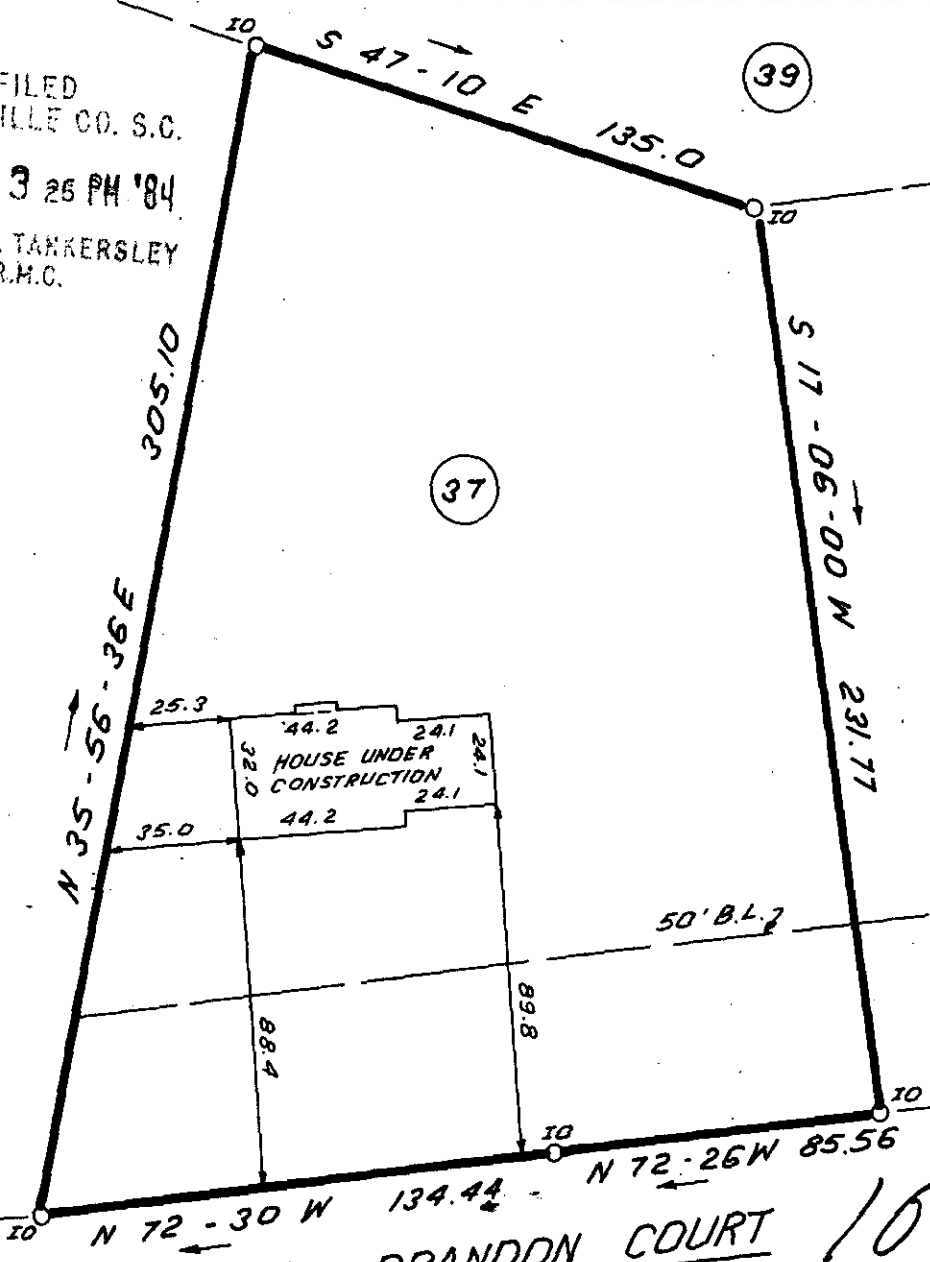

SEP 24 1984
V 9250

BRANDON COURT


10-X-43

NOTE: 5' DRAINAGE & UTILITY EASEMENT
EACH SIDE & REAR LOT LINES
UNLESS OTHERWISE SHOWN.



THIS IS TO CERTIFY THAT THE PROPERTY SHOWN ON THIS PLAT WAS SURVEYED UNDER MY DIRECT SUPERVISION. PROPERTY LINES AND IMPROVEMENTS SHOWN ARE LOCATED CORRECTLY AND THAT NO VISIBLE ENCROACHMENTS EXIST UNLESS OTHERWISE SHOWN. THIS PROPERTY IS NOT LOCATED IN A DESIGNATED FLOOD HAZARD AREA.

2 SEP 24 1984 858

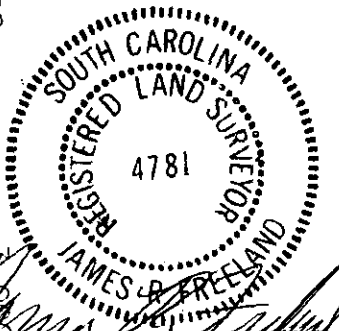

RES: JAMES R. FREELAND
NO: 4781

STATE OF SOUTH CAROLINA
GREENVILLE COUNTY

ASHETON
SEC. 2 ; LOT 37
PROPERTY OF
SAN-DEL BUILDERS

FREELAND & ASSOCIATES
Engineers • Land Surveyors
318 WEST STONE AVENUE.
GREENVILLE, S.C.
(803) 271-4924

| | |
|-------------|-------------|
| PLAT BOOK | 9F - 99 |
| DEED BOOK | |
| TAX MAP | 539.11-1-13 |
| PARTY CHIEF | J.C. |
| DRAWN | J.R. |
| DATE | 9-18-84 |
| DWG. NO. | 11782 |