


MICROFILMED

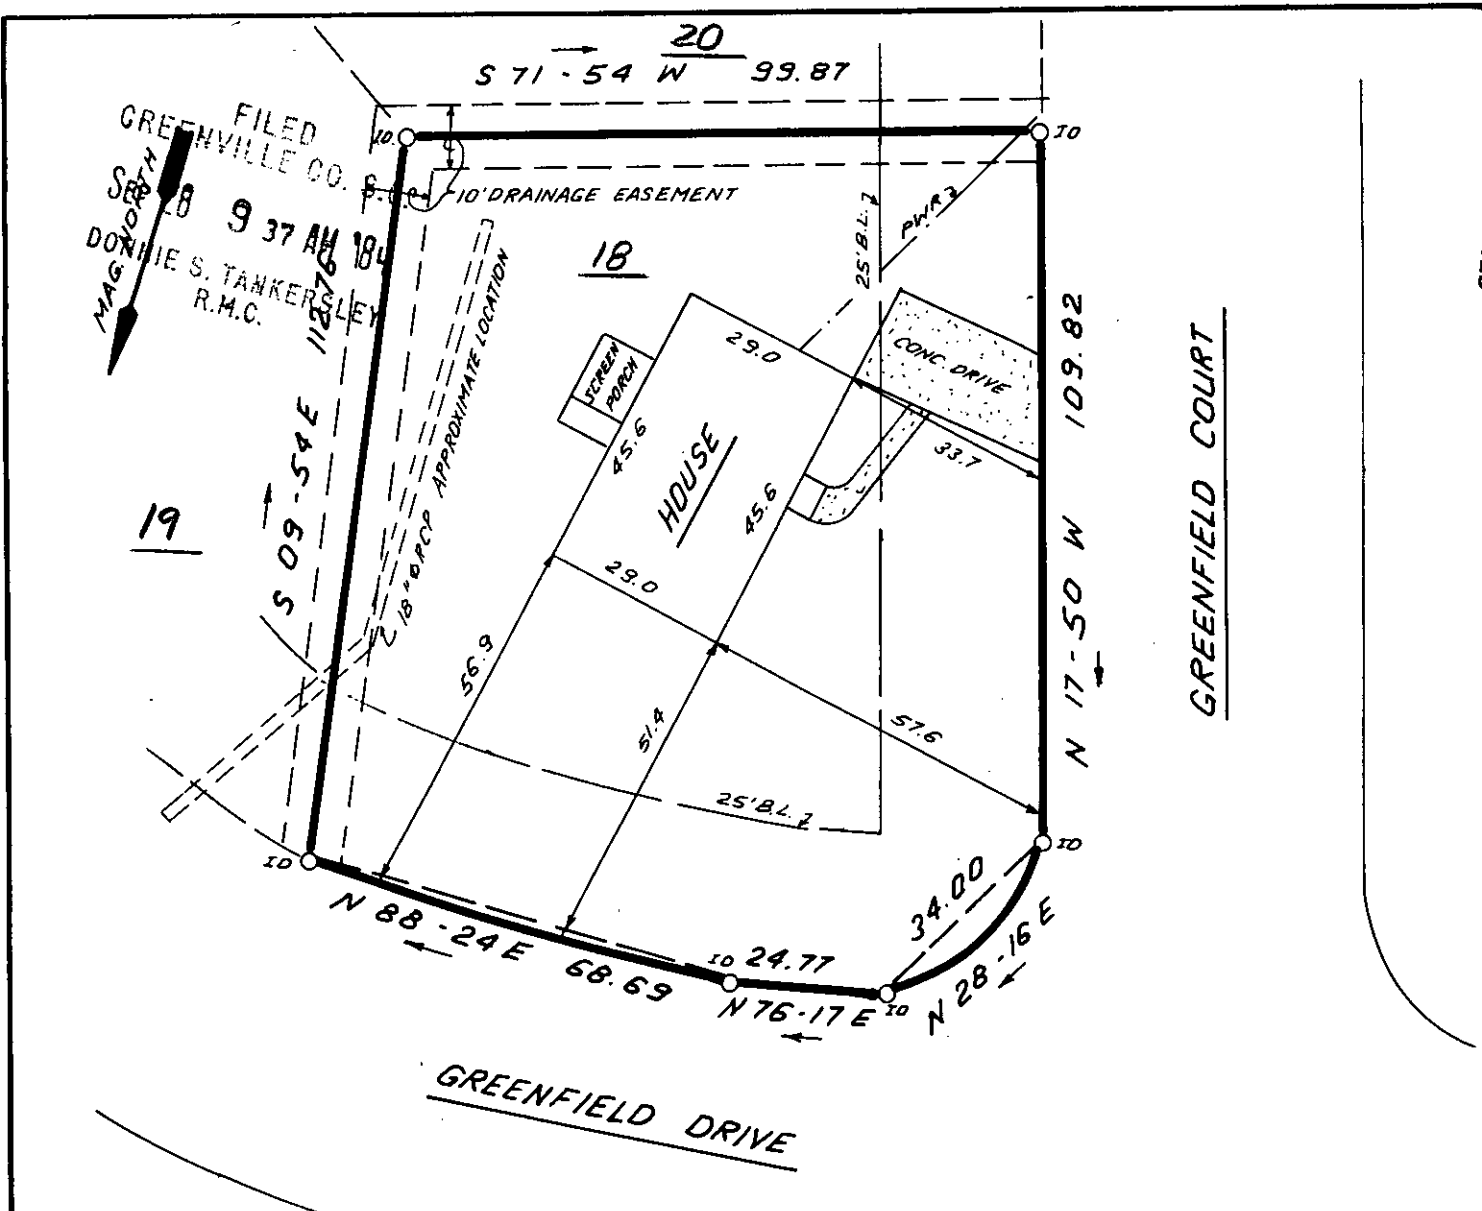

30 0 30 60
 SCALE: 1" = 30' FEET

SEP 28 1984

10-V-52

9862 ✓

THIS IS TO CERTIFY THAT THE PROPERTY SHOWN ON THIS PLAT WAS SURVEYED UNDER MY DIRECT SUPERVISION. PROPERTY LINES AND IMPROVEMENTS SHOWN ARE LOCATED CORRECTLY AND THAT NO VISIBLE ENCROACHMENTS EXIST UNLESS OTHERWISE SHOWN. THIS PROPERTY IS NOT LOCATED IN A DESIGNATED FLOOD HAZARD AREA.

SOUTH CAROLINA REGISTERED LAND SURVEYOR
 JAMES R. FREELAND
 NO. 4781

RLS: JAMES R. FREELAND
 NO: 4781

**STATE OF SOUTH CAROLINA
 GREENVILLE COUNTY**

FREELAND & ASSOCIATES
 Engineers • Land Surveyors
 318 WEST STONE AVENUE.
 GREENVILLE, S.C.
 (803) 271-4924

GREENFIELDS
LOT 18
PROPERTY OF
NANCY R. MILDE

PLAT BOOK	XX - 103
DEED BOOK	1123 - 860
TAX MAP	541.2 - 1 - 43
PARTY CHIEF	L. T.
DRAWN	I. R.
DATE	9 - 27 - 84
DWG. NO.	11825 - 0000

GCTO ----- 3 SE28 84 054