


FILED
GREENVILLE CO., S.C.
OCT 2 10 09 AM '84
DONNE S. TANKERSLEY
R.M.C.

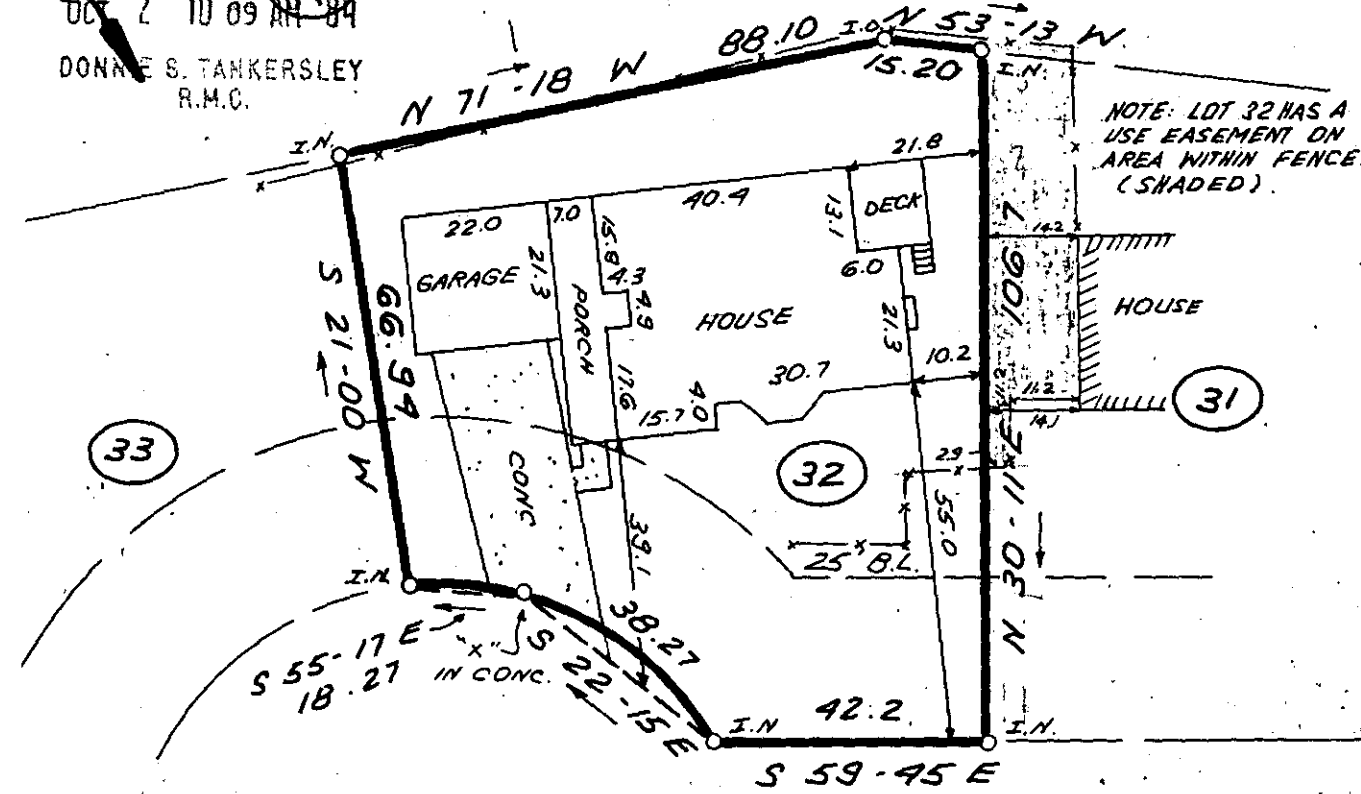

50' RAD.

TAMBURLAINE COURT

142.51' ± TO TILBURY WAY

OCT 2 1984

10179

10-Y-65



NOTE: 5' DRAINAGE & UTILITY EASEMENT ALONG ALL REAR & SIDE LOT LINES.

THIS IS TO CERTIFY THAT THE PROPERTY SHOWN ON THIS PLAT WAS SURVEYED UNDER MY DIRECT SUPERVISION PROPERTY LINES AND IMPROVEMENTS SHOWN ARE LOCATED CORRECTLY AND THAT NO VISIBLE ENCROACHMENTS EXIST UNLESS OTHERWISE SHOWN. THIS PROPERTY IS NOT LOCATED IN A DESIGNATED FLOOD HAZARD AREA.

SOUTH CAROLINA
REGISTERED LAND SURVEYOR
JAMES R. FREELAND

NO. 4781

STATE OF SOUTH CAROLINA
GREENVILLE COUNTY

STONE GLEN
LOT 32
PROPERTY OF
CAROLYN J. GILREATH

FREELAND & ASSOCIATES
Engineers • Land Surveyors
318 WEST STONE AVENUE.
GREENVILLE, S.C.
(803) 271-4924

PLAT BOOK 9W-96
DEED BOOK
TAX MAP
PARTY CHIEF R.A.J.
DRAWN K.E.G.
DATE SEPT 24, 1984
DWG. NO. 11803

SECT 20 OCT 2 84 1511