


WASHINGTON AVE
WATER & SEWER IN ST. R/W.
560-34 E

MICROFILMED

TEXAS AVENUE

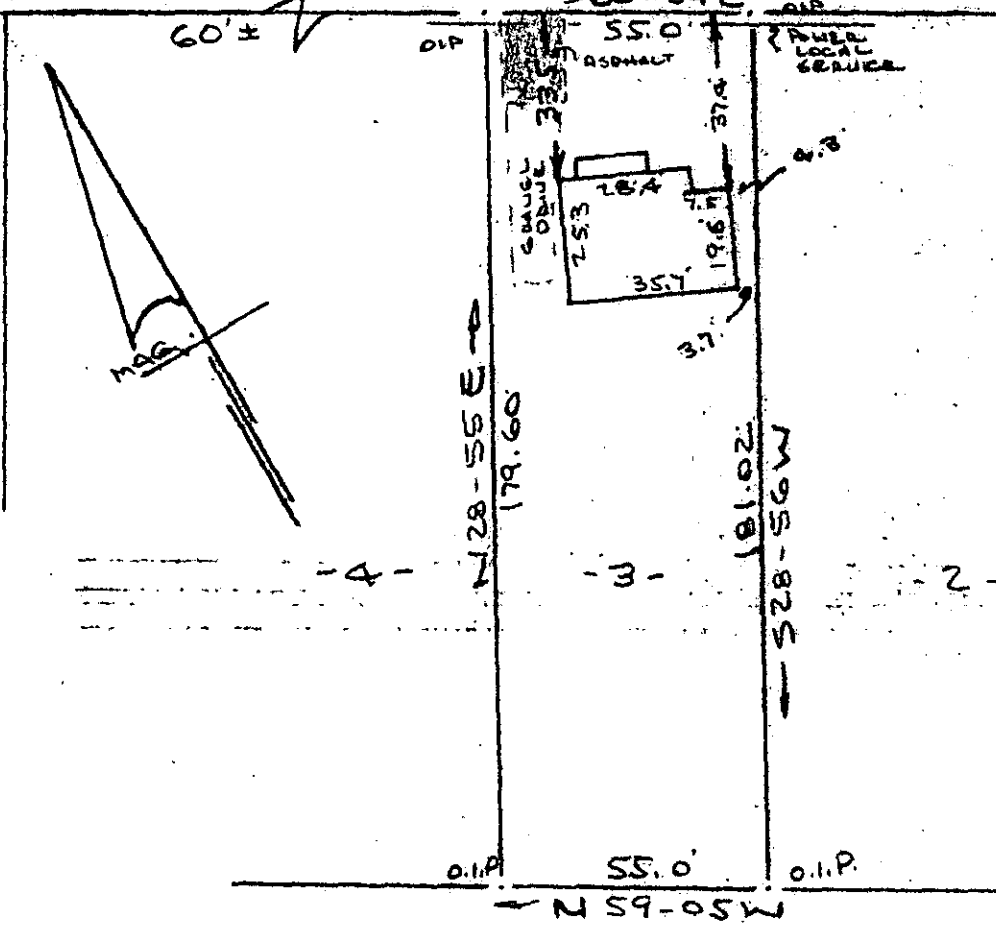

GREENVILLE CO. S.C.
FILED
OCT 10 9 17 AM '84
J. B. BRUCE, R.M.C.
R.M.C. OFFICE

Note:
Improvements on this
lot are not in a
flood hazard area.

PROPERTY OF
JONATHAN KELLY PRICE & ANGELA E. PRICE
NEAR GREENVILLE, S.C.
SCALE 1" = 40' 5 OCT 1984

This is to certify that on the 5th day of October, 1984, I surveyed the property shown on this plat, being known as part of lot 9 Block "A" on plat of H. K. POWLES and recorded in the RMC Office Greenville County, S. C., in Plat Book "Q" at Page 165 and also known as PROPERTY OF J. DEAN BLANKEN and recorded in Plat Book 8 - Y at Page 54; and that the property lines, walls and buildings are as shown hereon, and that the walls and buildings located on said lot do not encroach or project on adjacent street or property, and that no adjacent walls or buildings encroach or project on said premises, and no power lines cross this property except as shown hereon.

10873 ✓

10 Y-91

R. B. Bruce
R. B. Bruce, RLS #1952
R. B. Bruce
ANG SURV

OCT 10 1984

CAROLINA SURVEYING CO.
112 Manly St.
Greenville, S. C.

300 3
21A01

224/65

241-1-6

15380