MICROFILMED

FILED
GREENVILLE CO. S.C.
OCT 15 2 41 PM '84
DONNIE S. TANKERSLEY
R.M.C.

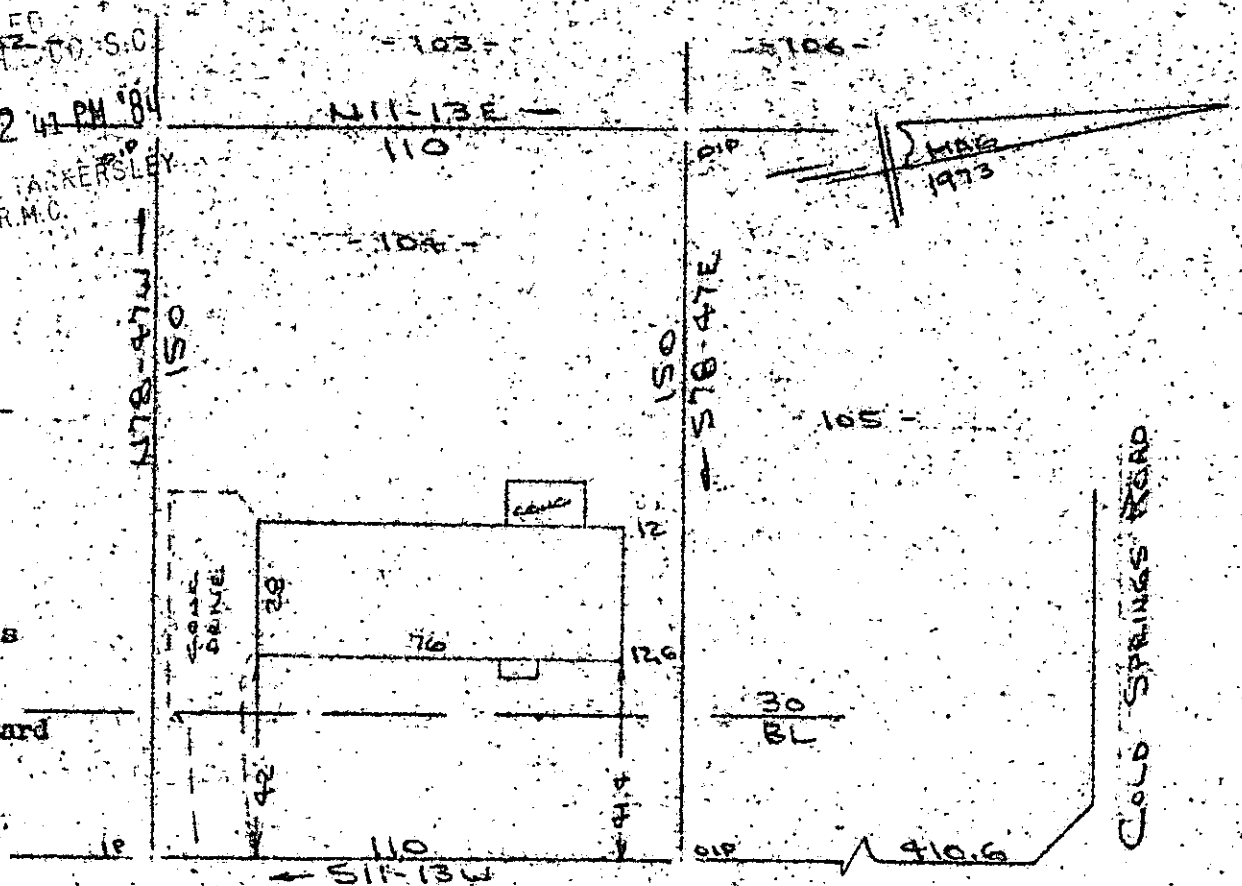

GILDER CREEK DRIVE
WATER & SEWER IN ST R/W

PROPERTY OF
JAMES MARK TAYLOR & CONNIE AULT TAYLOR
MAULDIN S. C.
SCALE: 1"=40' 10 OCT 1984

40 20 0 40

This is to certify that on the 10th day of October, 1984, I surveyed the property shown on this plat, being known as lot 104 on plat of SECTION TWO FORRESTER WOODS and recorded in the RMC Office Greenville County, S. C., in Plat Book " 4 - X " at Page 64; and that the property lines, walls and buildings are as shown hereon, and that the walls and buildings located on said lot do not encroach or project on adjacent street or property, and that no adjacent walls or buildings encroach or project on said premises, and no power lines cross this property except as shown hereon.

OCT 15 1984
11369

11 - A - 6

R. B. Bruce

R. B. Bruce, RLS # 1952

Recordable Plat

CAROLINA SURVEYING CO.
112 Manly St.
Greenville, S. C.

12 OCT 15 84 1336

$3.00CI