


FILED
GREENVILLE CO. S.C.
OCT 15 3 31 PM '84
DONNIE S. TAKERSLEY
R.M.C.


W/F
RYGARD HEUSEL

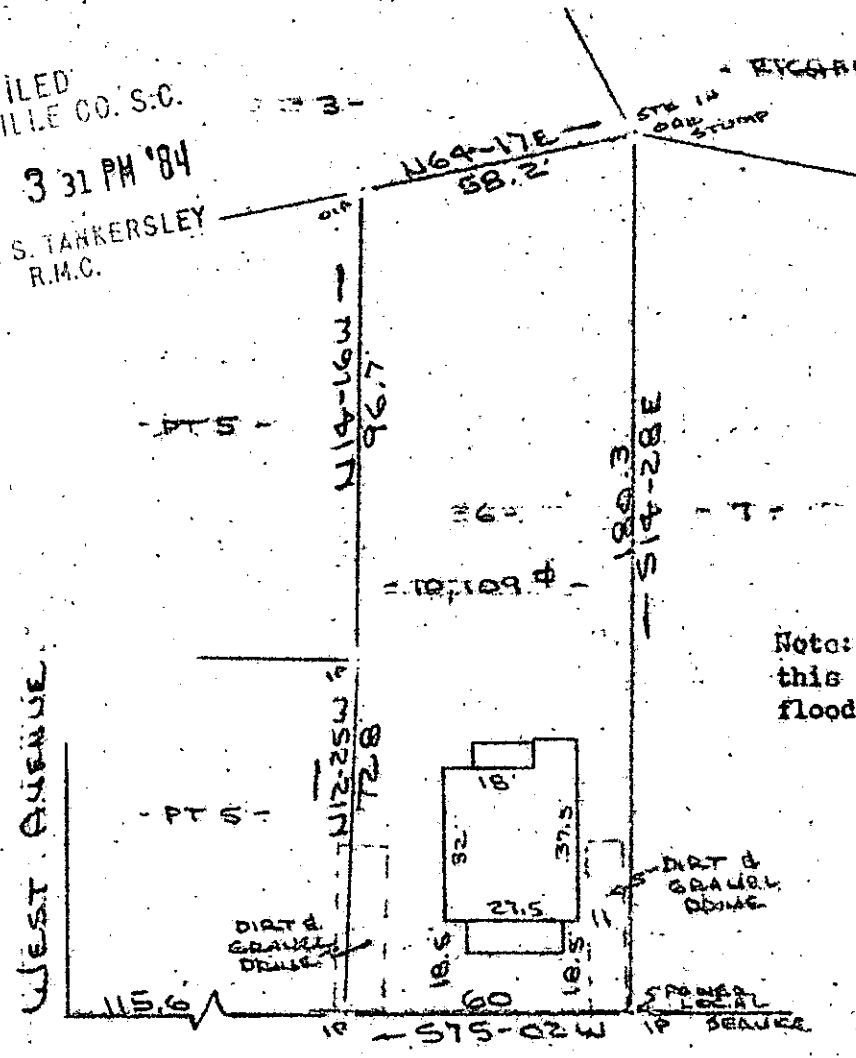

Note: Improvements on this lot are not in a flood hazard area.

WACO STREET
WATER & SEWER IN ST. R/W

PROPERTY OF
Q. R. FOXX PROPERTIES, A SOUTH CAROLINA GENERAL PARTNERSHIP
NEAR GREENVILLE, GREENVILLE COUNTY, S.C.
SCALE: 1"=40' 10 OCT 1984

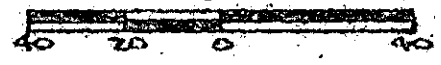

This is to certify that on the 10th day of October, 1984, I surveyed the property shown on this plat, being known as lot 6 on plat of PROPERTY OF J. R. WEST and recorded in the REC Office Greenville County, S. C., in Plat Book "C" at Page 190 and also known as PROPERTY OF Q. R. FOXX PROPERTIES, A SOUTH CAROLINA GENERAL PARTNERSHIP and recorded in Plat Book _____ at Page _____; and that the property lines, walls and buildings are as shown hereon, and that the walls and buildings located on said lot do not encroach or project on adjacent street or property, and that no adjacent walls or buildings encroach or project on said premises, and no power lines cross this property except as shown hereon.

OCT 15 1984
11372

11A-9

R. B. Bruce
R. B. Bruce, RLS # 1952

CAROLINA SURVEYING CO.
112 Manly St.
Greenville, S. C.

Recordable Plat

2 OCT 15 34 1347

3.00CT