

FILED
 GREENVILLE CO. S.C.
 OCT 17 3 07 PM '84
 DONNIE S. TANKERSLEY
 R.M.C.

80'± TO
 EAST MILL COURT

MILL ESTATES ROAD

OCT 17 1984

11629 11A-13



NOTE: 5' DRAINAGE & UTILITY EASEMENT EACH SIDE OF ALL SIDE & REAR LOT LINES.


THIS IS TO CERTIFY THAT THE PROPERTY SHOWN ON THIS PLAT WAS SURVEYED UNDER MY DIRECT SUPERVISION PROPERTY LINES AND IMPROVEMENTS SHOWN ARE LOCATED CORRECTLY AND THAT NO VISIBLE ENCROACHMENTS EXIST UNLESS OTHERWISE SHOWN THIS PROPERTY IS NOT LOCATED IN A DESIGNATED FLOOD HAZARD AREA

STATE OF SOUTH CAROLINA
 GREENVILLE COUNTY

FREELAND & ASSOCIATES
 Engineers • Land Surveyors
 318 WEST STONE AVENUE
 GREENVILLE, S.C.
 (803) 271-4924

OLD MILL ESTATES
SEC. 3, LOT 2
PROPERTY OF
JAMES LARRY BLACKMON

PLAT BOOK	8P-3
DEED BOOK	
TAX MAP	
PARTY CHIEF	J.E.C.
DRAWN	I.R.
DATE	10-15-84
DWG NO	11898

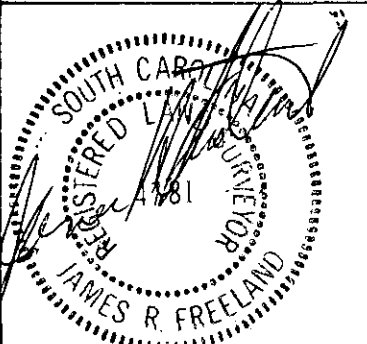

RLS JAMES R. FREELAND
 NO: 4781

2 OCT 17 84
 043
 3 OCT 1