


MICROFILMED

FILED
GREENVILLE CO. S.C.
OCT 18 1 38 PM '84
DONNIE S. TANKERSLEY
R.M.C.

2

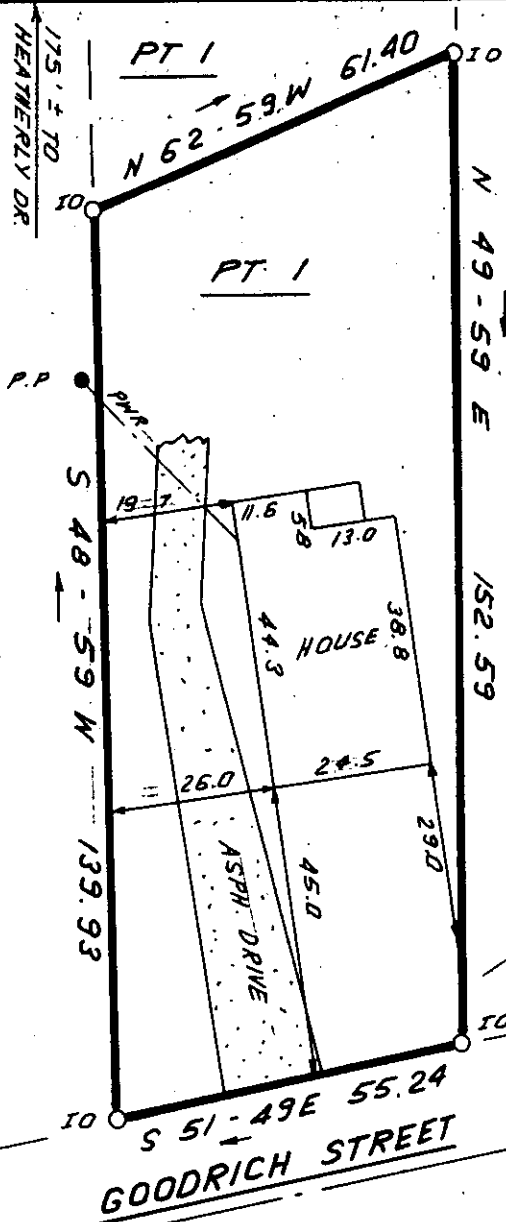

4

3

2



OCT 18 1984

11831

11A-18



THIS IS TO CERTIFY THAT THE PROPERTY SHOWN ON THIS PLAT WAS SURVEYED UNDER MY DIRECT SUPERVISION PROPERTY LINES AND IMPROVEMENTS SHOWN ARE LOCATED CORRECTLY AND THAT NO VISIBLE ENCROACHMENTS EXIST UNLESS OTHERWISE SHOWN. THIS PROPERTY IS NOT LOCATED IN A DESIGNATED FLOOD HAZARD AREA

STATE OF SOUTH CAROLINA
GREENVILLE COUNTY

FREELAND & ASSOCIATES
Engineers • Land Surveyors
318 WEST STONE AVENUE.
GREENVILLE, S.C.
(803) 271-4924

JUDSON MILL PROPERTY
PART LOT 1
PROPERTY OF
FRED M. HYATT
FRED M. HYATT

PLAT BOOK	E 235
DEED BOOK	1166 - 602
TAX MAP	110 - 5 - 5
PARTY CHIEF	R.P.
DRAWN	J.R.
DATE	10-12-84
DWG NO	11888

SOUTH CAROLINA
REGISTERED LAND SURVEYOR
4781
JAMES R. FREELAND

RLS JAMES R. FREELAND
NO: 4781