


GREENVILLE CO. S.C.
OCT 31 2 42 PM '84
DONNIE S. LUKERSLEY
R.H.C.

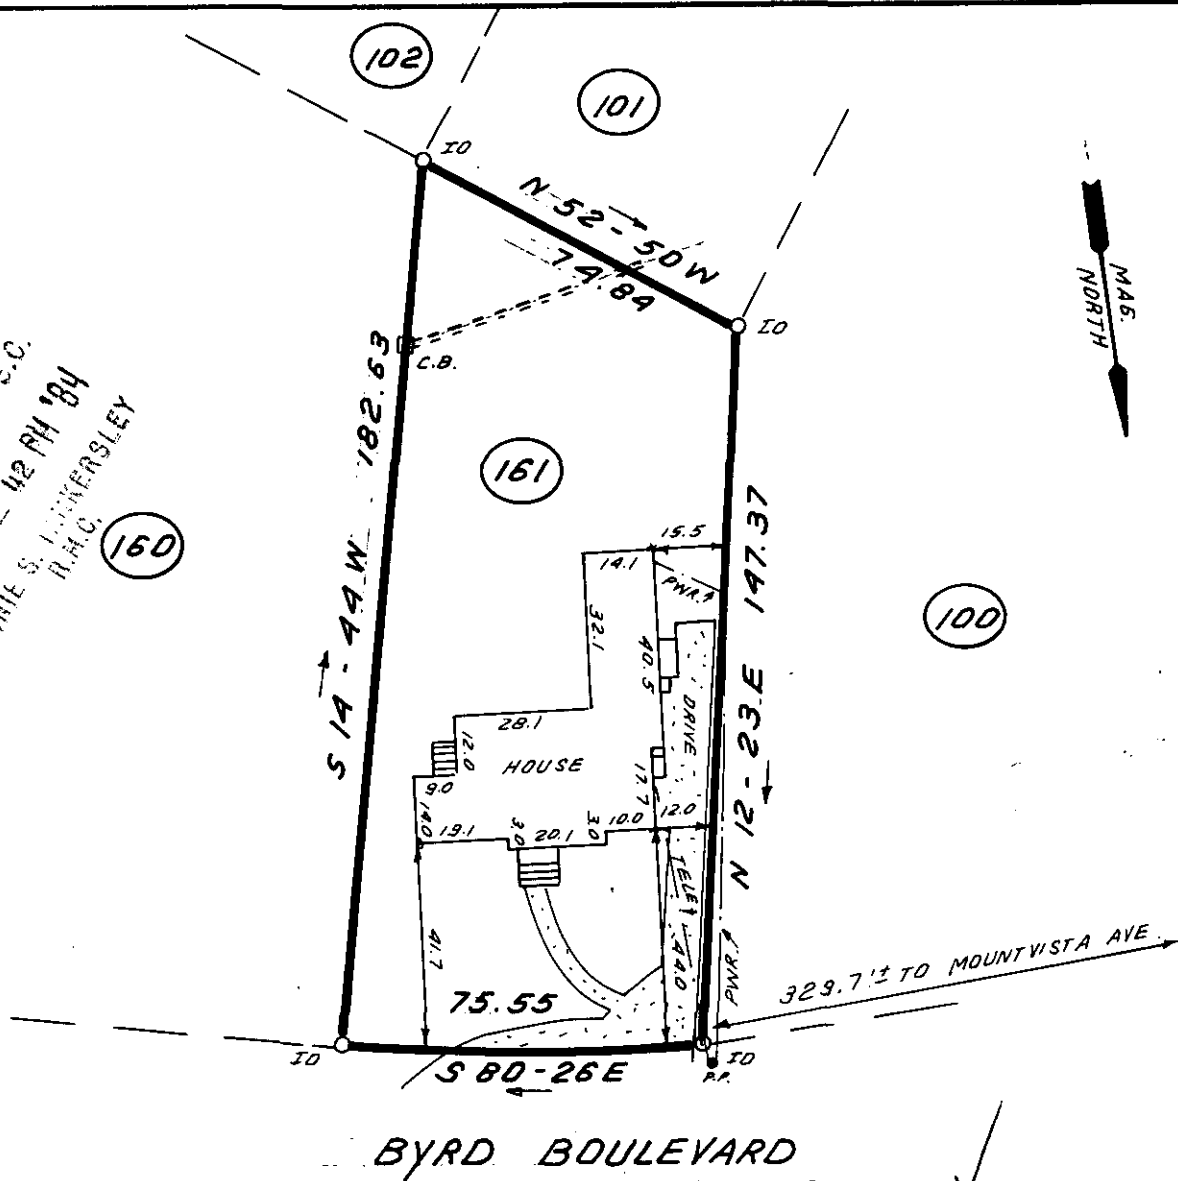


BYRD BOULEVARD


13109

11-A-72

OCT 31 1984

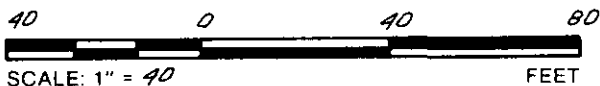

THIS IS TO CERTIFY THAT THE PROPERTY SHOWN ON THIS PLAT WAS SURVEYED UNDER MY DIRECT SUPERVISION. PROPERTY LINES AND IMPROVEMENTS SHOWN ARE LOCATED CORRECTLY AND THAT NO VISIBLE ENCROACHMENTS EXIST UNLESS OTHERWISE SHOWN. THIS PROPERTY IS NOT LOCATED IN A DESIGNATED FLOOD HAZARD AREA.

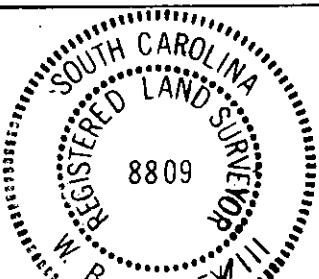

W. B. HUNTLEY
RLS: W. B. HUNTLEY III
NO: 8809

STATE OF SOUTH CAROLINA
GREENVILLE COUNTY

TRAXLER PARK
LDT 161
PROPERTY OF
THOMAS A. MANN

FREELAND & ASSOCIATES
Engineers • Land Surveyors
318 WEST STONE AVENUE.
GREENVILLE, S.C.
(803) 271-4924

PLAT BOOK	F 114-115
DEED BOOK	1189-151
TAX MAP	207-1-2
PARTY CHIEF	JEC
DRAWN	BR
DATE	10-19-84
DWG. NO.	11925

2 OCT 31 84 090 3.000CI