

FILED
 GREENVILLE CO. S.C.
 NOV 29 4 38 PM '84
 DONNIE S. TANKERSLEY
 R.M.C.


16343

11-B-36

NOV 29 1984



THIS IS TO CERTIFY THAT THE PROPERTY SHOWN ON THIS PLAT WAS SURVEYED UNDER MY DIRECT SUPERVISION. PROPERTY LINES AND IMPROVEMENTS SHOWN ARE LOCATED CORRECTLY AND THAT NO VISIBLE ENCROACHMENTS EXIST UNLESS OTHERWISE SHOWN. THIS PROPERTY IS NOT LOCATED IN A DESIGNATED FLOOD HAZARD AREA.

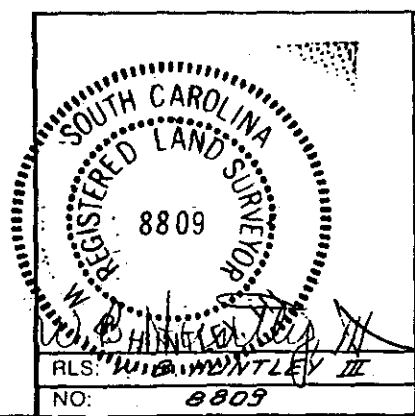

**STATE OF SOUTH CAROLINA
 GREENVILLE COUNTY**

EMMA C. POAG PROPERTY
LOTS 7 & 26
PROPERTY OF
THE J.H. HEAFNER COMPANY, INC.

FREELAND & ASSOCIATES Engineers • Land Surveyors 318 WEST STONE AVENUE. GREENVILLE, S.C. (803) 271-4924	
PLAT BOOK	K - 68
DEED BOOK	
TAX MAP	198 - 3 - 1
PARTY CHIEF	J. E. C.
DRAWN	I. R.
DATE	10 - 19 - 84
DWG. NO.	11922