

GREENVILLE FILED

NOV 10 4 05 PM '84  
DONNIE R. MCGEE

N/E  
LARRY STEVEN JONES

Map  
1975


Note: Improvements on this lot are not in a flood hazard area.

GC70 - I NO. 885 043

3.00CD



PROPERTY OF  
JAMES D. SEWARD JR  
NEAR GREENVILLE GREENVILLE COUNTY, S.C.  
SCALE 1"=50' 8 NOV 1984

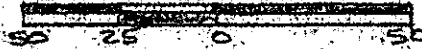

This is to certify that on the 8th day of November, 1984, I surveyed the property shown on this plat, being known as 0.95 acres on plat of PROPERTY OF JAMES D. SEWARD, JR. and recorded in the RMC Office Greenville County, S. C., in Plat Book " " at Page ; and that the property lines, walls and buildings are as shown hereon, and that the walls and buildings located on said lot do not encroach or project on adjacent street or property, and that no adjacent walls or buildings encroach or project on said premises, and no power lines cross this property except as shown hereon.

14155 ✓  
NOV 8 1984

11C-3

CAROLINA SURVEYING CO.  
112 Hanly St.  
Greenville, S. C.

R. B. Bruce  
R. B. Bruce, RLS # 1952  
Recordable Plat

274/88

53A 7-1-PT 45

(10709)

UNRECORDED