


WADE HAMPTON FIRE & SEWER DISTRICT N/F

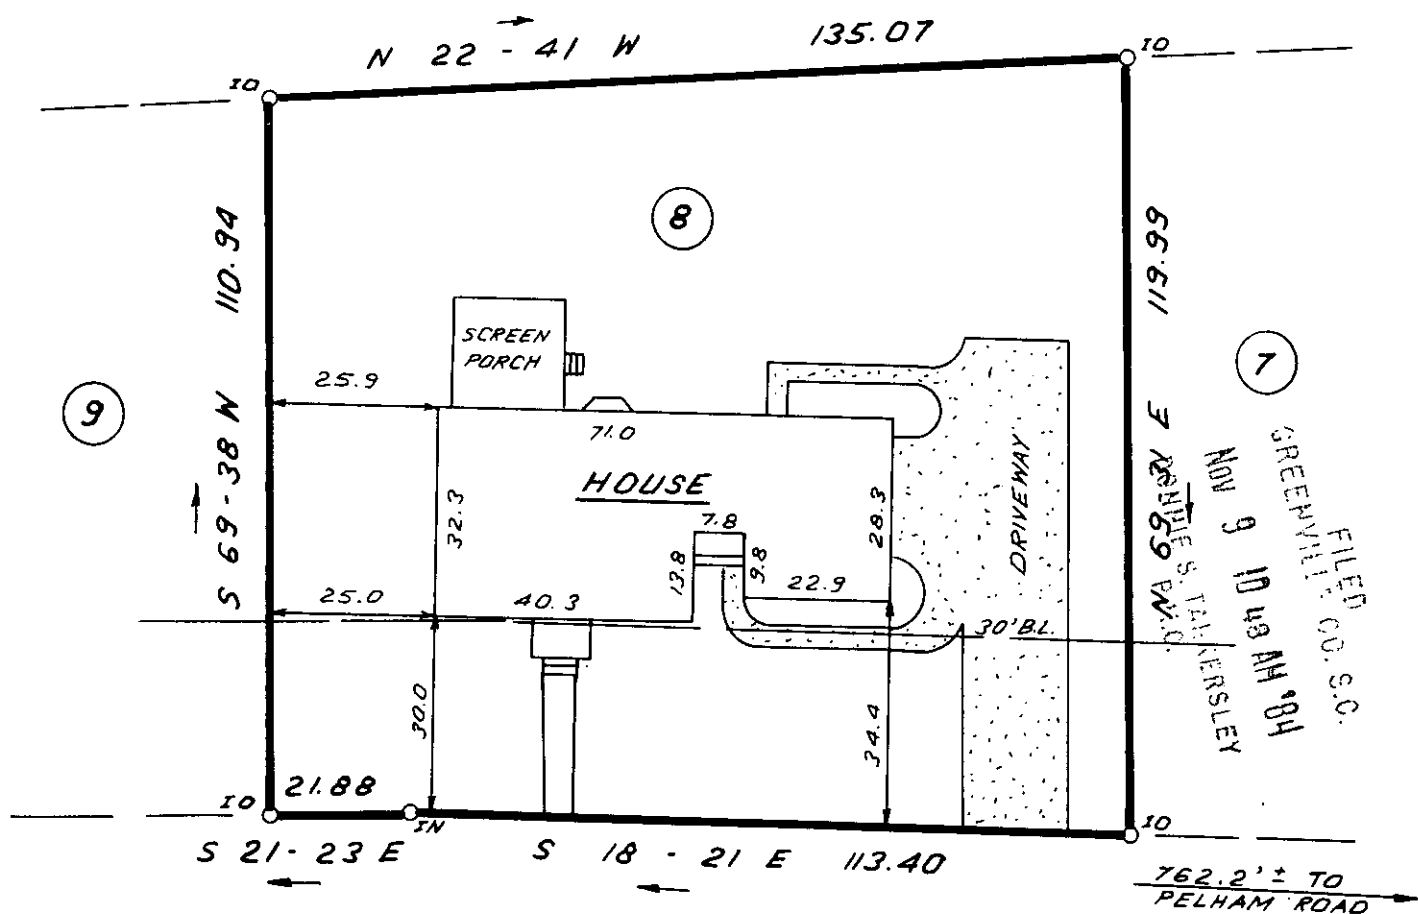

FILED  
 GREENVILLE CO. S.C.  
 NOV 9 10 48 AM '84  

ASHWICKE LANE

14231

NOV 9 1984

11-C-5



NOTE: 5' DRAINAGE & UTILITY EASEMENT OF ALL SIDE LOT LINES, AND 10' OF ALL REAR LOT LINES.

THIS IS TO CERTIFY THAT THE PROPERTY SHOWN ON THIS PLAT WAS SURVEYED UNDER MY DIRECT SUPERVISION. PROPERTY LINES AND IMPROVEMENTS SHOWN ARE LOCATED CORRECTLY AND THAT NO VISIBLE ENCROACHMENTS EXIST UNLESS OTHERWISE SHOWN. THIS PROPERTY IS NOT LOCATED IN A DESIGNATED FLOOD HAZARD AREA

**REGISTERED SURVEYOR**  
 JAMES R. FREELAND  
 NO: 4781  
 RLS: JAMES R. FREELAND  
 NO: 4781

**STATE OF SOUTH CAROLINA**  
**GREENVILLE COUNTY**

ASHWICKE  
LOT 8  
PROPERTY OF  
ANDREW J. VECCHIONE  
IRENE M. VECCHIONE

**FREELAND & ASSOCIATES**  
 Engineers • Land Surveyors  
 318 WEST STONE AVENUE.  
 GREENVILLE, S.C.  
 (803) 271-4924

PLAT BOOK	9 N - 60
DEED BOOK	1224 - 94
TAX MAP	
PARTY CHIEF	B.G.
DRAWN	I.R.
DATE	11-7-84
DWG NO	12045

2 NOV 9 1984 1309 3.0002