MICROFILMED

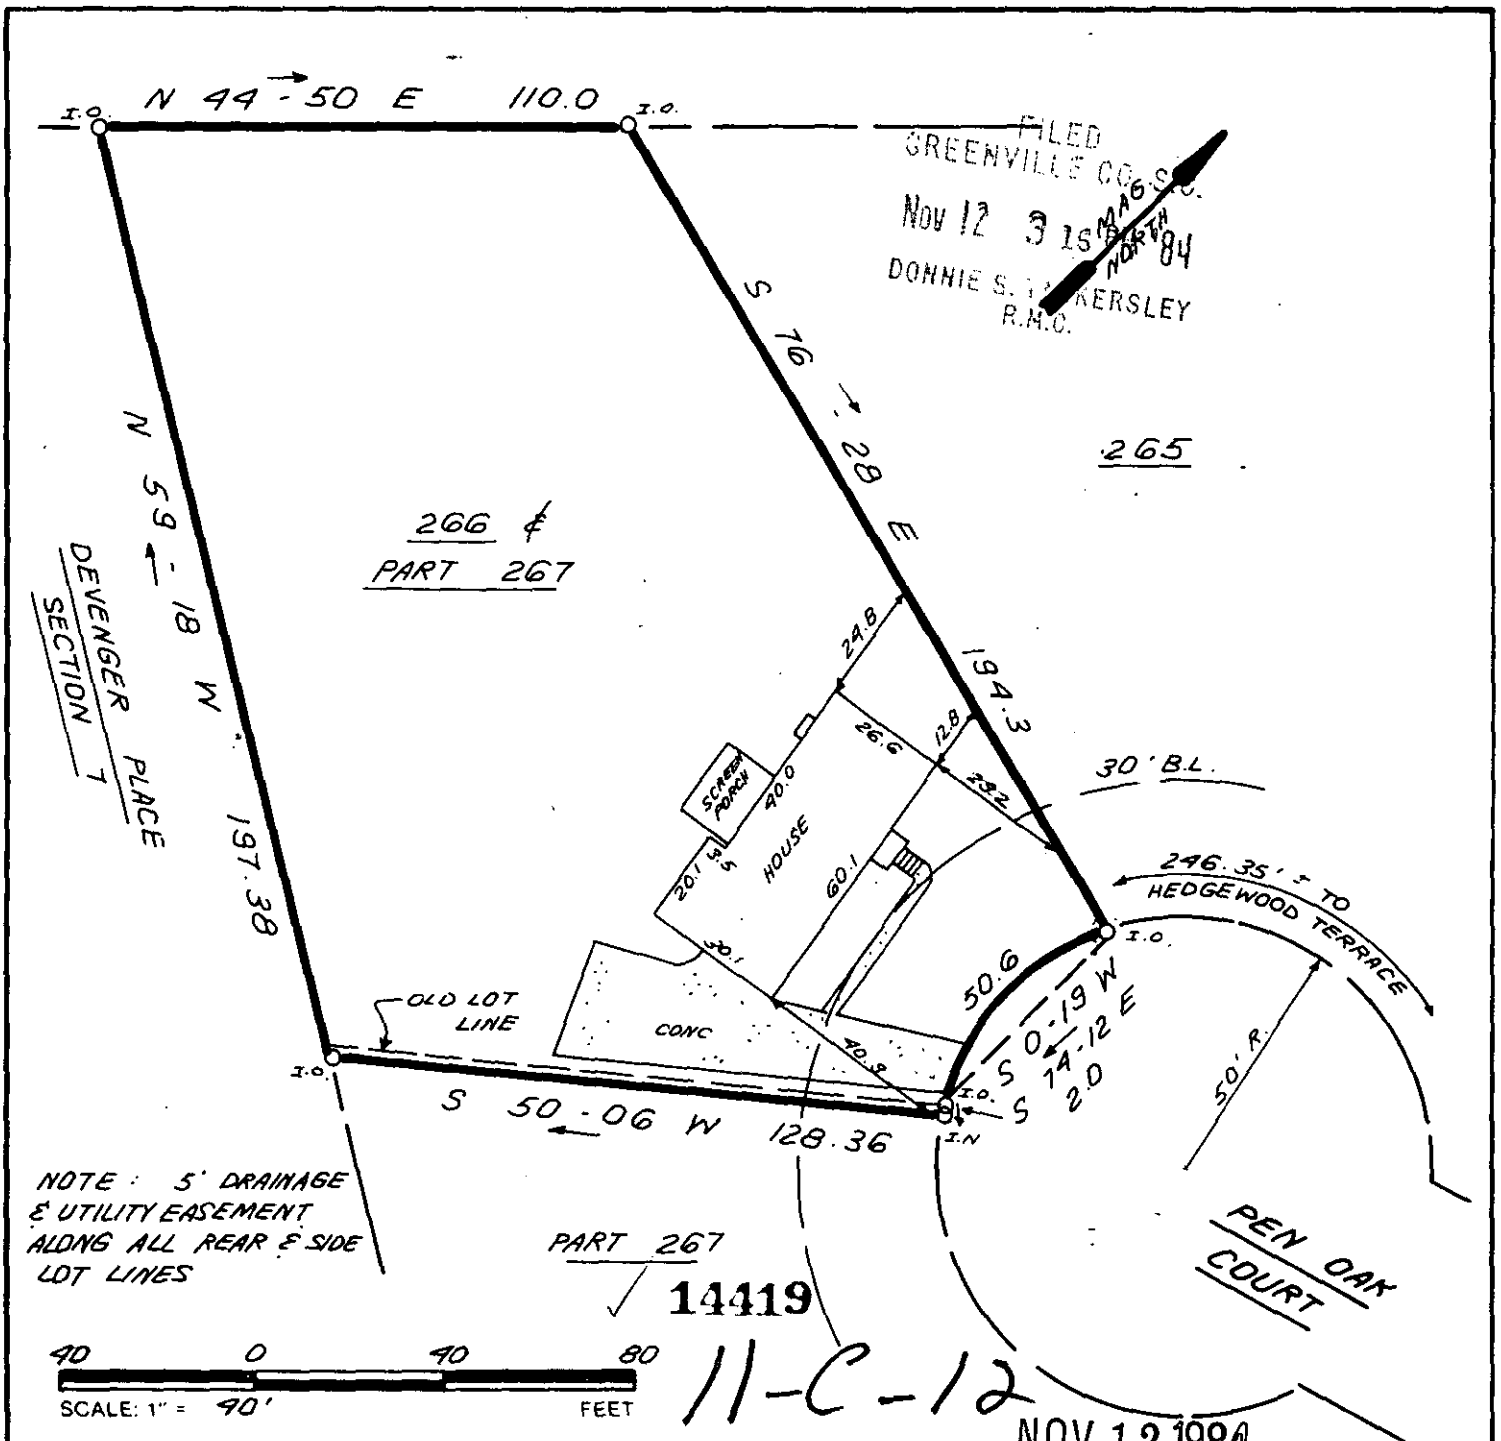

THIS IS TO CERTIFY THAT THE PROPERTY SHOWN ON THIS PLAT WAS SURVEYED UNDER MY DIRECT SUPERVISION PROPERTY LINES AND IMPROVEMENTS SHOWN ARE LOCATED CORRECTLY AND THAT NO VISIBLE ENCROACHMENTS EXIST UNLESS OTHERWISE SHOWN. THIS PROPERTY IS NOT LOCATED IN A DESIGNATED FLOOD HAZARD AREA

SOUTH CAROLINA REGISTERED LAND SURVEYOR 4781 JAMES R. FREELAND

RLS: JAMES R. FREELAND
NO: 4781

STATE OF SOUTH CAROLINA
GREENVILLE COUNTY

DEVENGER PLACE
SEC. 12, LOT 266 & PT. 267
PROPERTY OF
JOHN W. CAMERON &
BARBARA J. CAMERON

FREELAND & ASSOCIATES
Engineers • Land Surveyors
318 WEST STONE AVENUE.
GREENVILLE, S.C.
(803) 271-4924

PLAT BOOK	7X - 18
DEED BOOK	1132 - 645 & 1147-648
TAX MAP	540.14-1-161
PARTY CHIEF	J.C.
DRAWN	K.E.G.
DATE	NOV. 9, 1984
DWG. NO.	12053

THE PRINT MACHINE, INC. N48640

7-TO 2 NOV 12 84 1477 3.00CI