


15

16

22

21

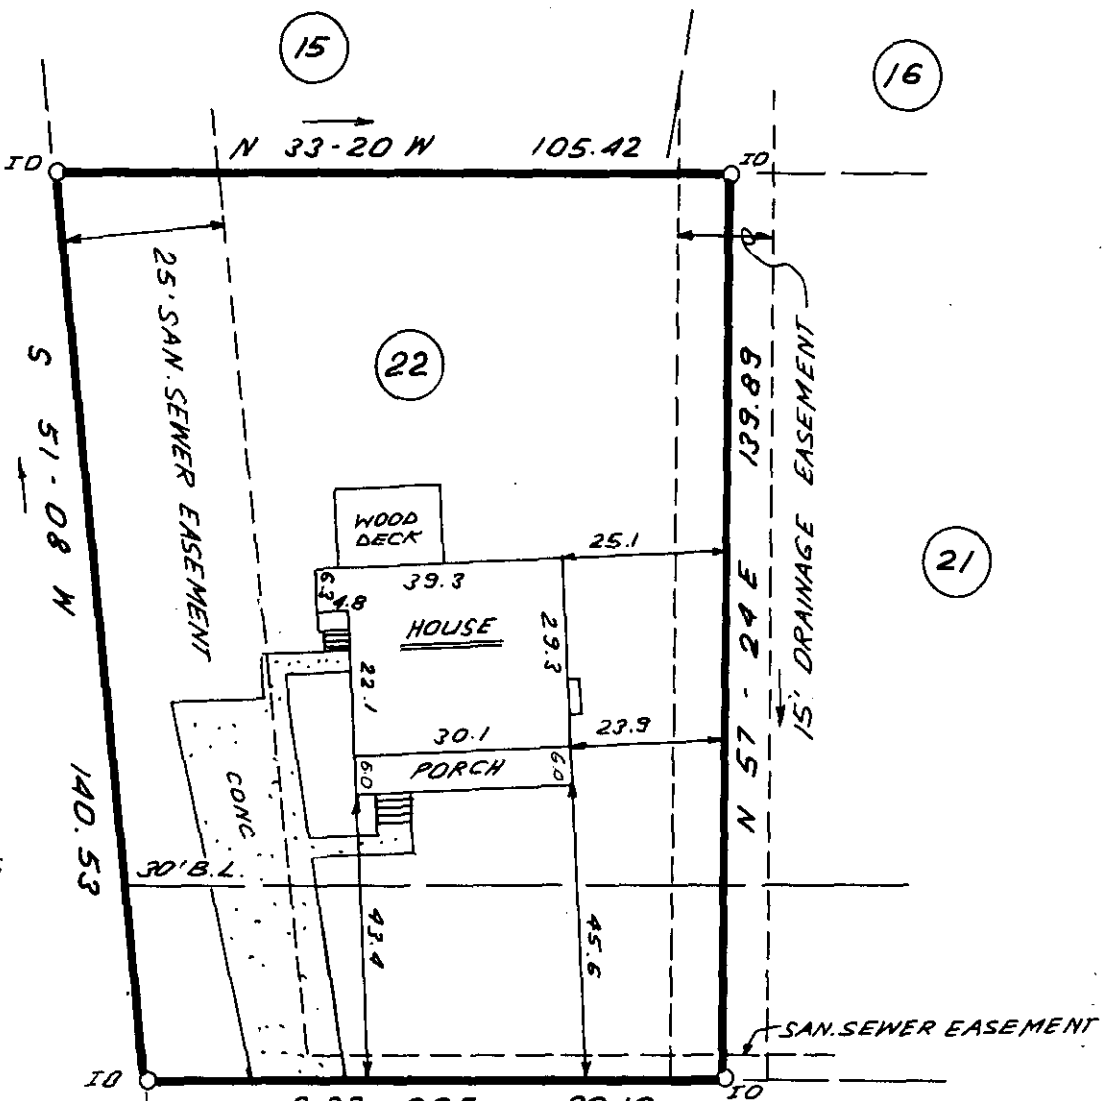

FILED
GREENVILLE, S.C.
NOV 15 5 11 AM '84
DONNIE S. WATKINS
R.M.C.

150.35' ± TO
BALCOMBE ROAD

HOLLAND ROAD

NOV 15 1984
14774
11-C-23



NOTE: 5' DRAINAGE & UTILITY EASEMENT
ALONG EACH SIDE OF ALL SIDE
AND REAR LOT LINES.

THIS IS TO CERTIFY THAT THE PROPERTY SHOWN ON THIS PLAT WAS SURVEYED UNDER MY DIRECT SUPERVISION. PROPERTY LINES AND IMPROVEMENTS SHOWN ARE LOCATED CORRECTLY AND THAT NO VISIBLE ENCROACHMENTS EXIST UNLESS OTHERWISE SHOWN. THIS PROPERTY IS NOT LOCATED IN A DESIGNATED FLOOD HAZARD AREA.

STATE OF SOUTH CAROLINA
GREENVILLE COUNTY

FREELAND & ASSOCIATES
Engineers • Land Surveyors
318 WEST STONE AVENUE.
GREENVILLE, S.C.
(803) 271-4924

GILDER CREEK ESTATES
PHASE I; LOT 22
PROPERTY OF
DAVID L. EARNEST
LYNN M. EARNEST

PLAT BOOK	9W-68
DEED BOOK	
TAX MAP	
PARTY CHIEF	J.C.
DRAWN	J.R.
DATE	NOV. 6, 1984
DWG. NO.	12029-0001

RLS: JAMES R. FREELAND
NO: 4781