

FILED
GREENVILLE CO. S.C.

Nov 16 10 05 AM '84

DONNIE S. TALKERSLEY
R.M.C.

CHEROKEE FOREST NO. 3

TULANE CIRCLE

S 73-52 E 196.4

N 16-08 E 125.0


N 28-52 W 35.4

N 73-52 W 84.9

ROSEMARY LANE

S 40-31 W 139.3
CP DUKE POWER R/W
(68' TOTAL)

34

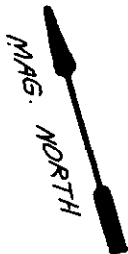

14964


11-C-32

NOV 16 1984



NOTE: 5' DRAINAGE & UTILITY EASEMENT EACH SIDE OF ALL SIDE & REAR LOT LINES.

THIS IS TO CERTIFY THAT THE PROPERTY SHOWN ON THIS PLAT WAS SURVEYED UNDER MY DIRECT SUPERVISION. PROPERTY LINES AND IMPROVEMENTS SHOWN ARE LOCATED CORRECTLY AND THAT NO VISIBLE ENCROACHMENTS EXIST UNLESS OTHERWISE SHOWN. THIS PROPERTY IS NOT LOCATED IN A DESIGNATED FLOOD HAZARD AREA

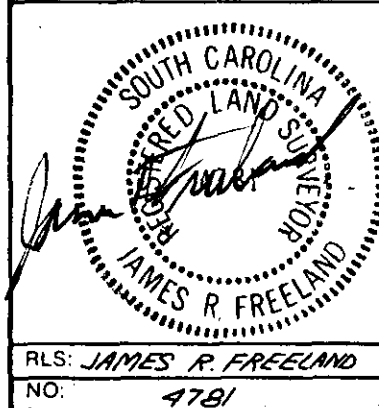

**STATE OF SOUTH CAROLINA
GREENVILLE COUNTY**

ROSEDALE
LOT 34
PROPERTY OF
JEFFREY G. TAYLOR

FREELAND & ASSOCIATES
Engineers • Land Surveyors
318 WEST STONE AVENUE.
GREENVILLE, S.C.
(803) 271-4924

| | |
|-------------|---------------|
| PLAT BOOK | 99 @ 113 |
| DEED BOOK | |
| TAX MAP | |
| PARTY CHIEF | J.E.C. |
| DRAWN | K.E.G. |
| DATE | OCT. 24, 1984 |
| DWG NO. | 11942 |

RLS: JAMES R. FREELAND
NO: 4781