


MICROFILMED

P&N RAILROAD

FILED  
GREENVILLE CO. S.C.

Nov 21 2 30 PM '84

DONNIE S. TANKERSLEY  
R.M.C.

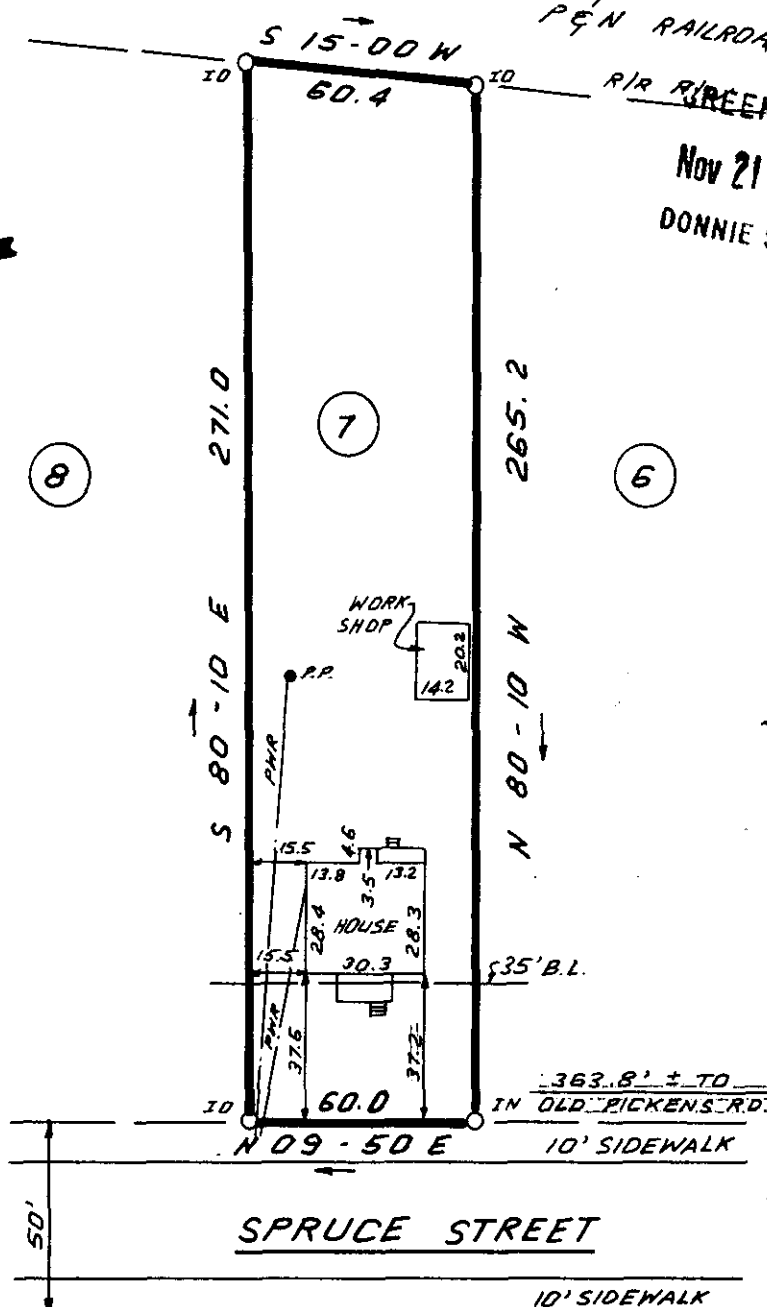

15564

NOV 21 1984

✓ 11C-55

50 0 50 100  
SCALE: 1" = 50' FEET

THIS IS TO CERTIFY THAT THE PROPERTY SHOWN ON THIS PLAT WAS SURVEYED UNDER MY DIRECT SUPERVISION. PROPERTY LINES AND IMPROVEMENTS SHOWN ARE LOCATED CORRECTLY AND THAT NO VISIBLE ENCROACHMENTS EXIST UNLESS OTHERWISE SHOWN. THIS PROPERTY IS NOT LOCATED IN A DESIGNATED FLOOD HAZARD AREA.

STATE OF SOUTH CAROLINA  
GREENVILLE COUNTY

FREELAND & ASSOCIATES  
Engineers • Land Surveyors  
318 WEST STONE AVENUE.  
GREENVILLE, S.C.  
(803) 271-4924

WOODVILLE HEIGHTS  
SEC. D, LOT 1  
PROPERTY OF  
GERALD R. GLUR

PLAT BOOK	L-14-15
DEED BOOK	1224-654
TAX MAP	127-4-12
PARTY CHIEF	R.A.J.
DRAWN	J.R.
DATE	11-20-84
DWG. NO.	12095

RLS: JAMES R. FREELAND  
NO: 4781

2021 21 796 3.0001