


FILED
GREENVILLE CO. S.C.
Nov 27 12 31 PM '84
DONNIE S. TANKERSLEY
R.M.C.

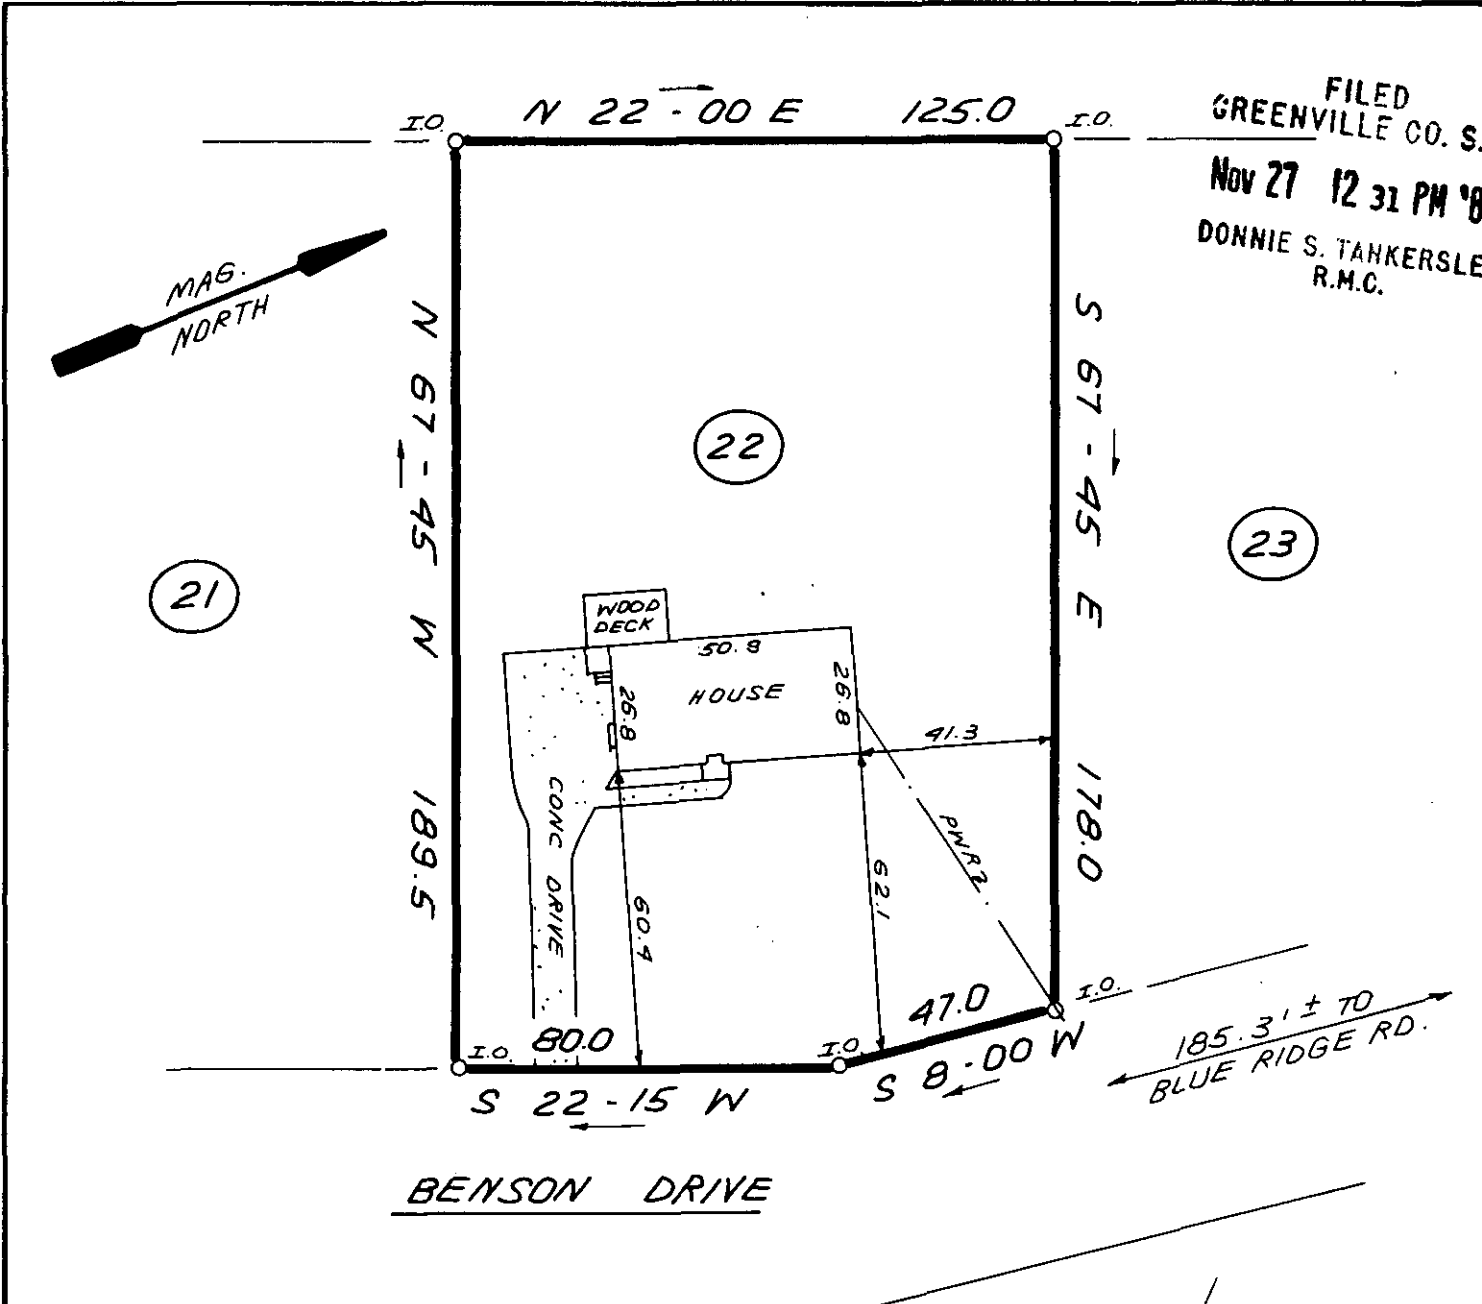

11-C-74 ✓ 16029

THIS IS TO CERTIFY THAT THE PROPERTY SHOWN ON THIS PLAT WAS SURVEYED UNDER MY DIRECT SUPERVISION PROPERTY LINES AND IMPROVEMENTS SHOWN ARE LOCATED CORRECTLY AND THAT NO VISIBLE ENCROACHMENTS EXIST UNLESS OTHERWISE SHOWN THIS PROPERTY IS NOT LOCATED IN A DESIGNATED FLOOD HAZARD AREA

300 3 31A01



**STATE OF SOUTH CAROLINA
GREENVILLE COUNTY**

SPRINGFIELD
LOT 22
PROPERTY OF
ALBERT C. BENNETT
LINDA BENNETT ♂

FREELAND & ASSOCIATES
Engineers • Land Surveyors
318 WEST STONE AVENUE.
GREENVILLE, S.C.
(803) 271-4924

PLAT BOOK	XX @ III
DEED BOOK	
TAX MAP	503.4-1-2
PARTY CHIEF	R.J.
DRAWN	K.E.G.
DATE	NOV. 21, 1984
DWG NO	12102

RLS. JAMES R. FREELAND
NO 4781