MICROFILMED

FILED
GREENVILLE CO. S.C.
DEC 3 11 57 AM '84
DONNIE S. TANKERSLEY
R.M.C.

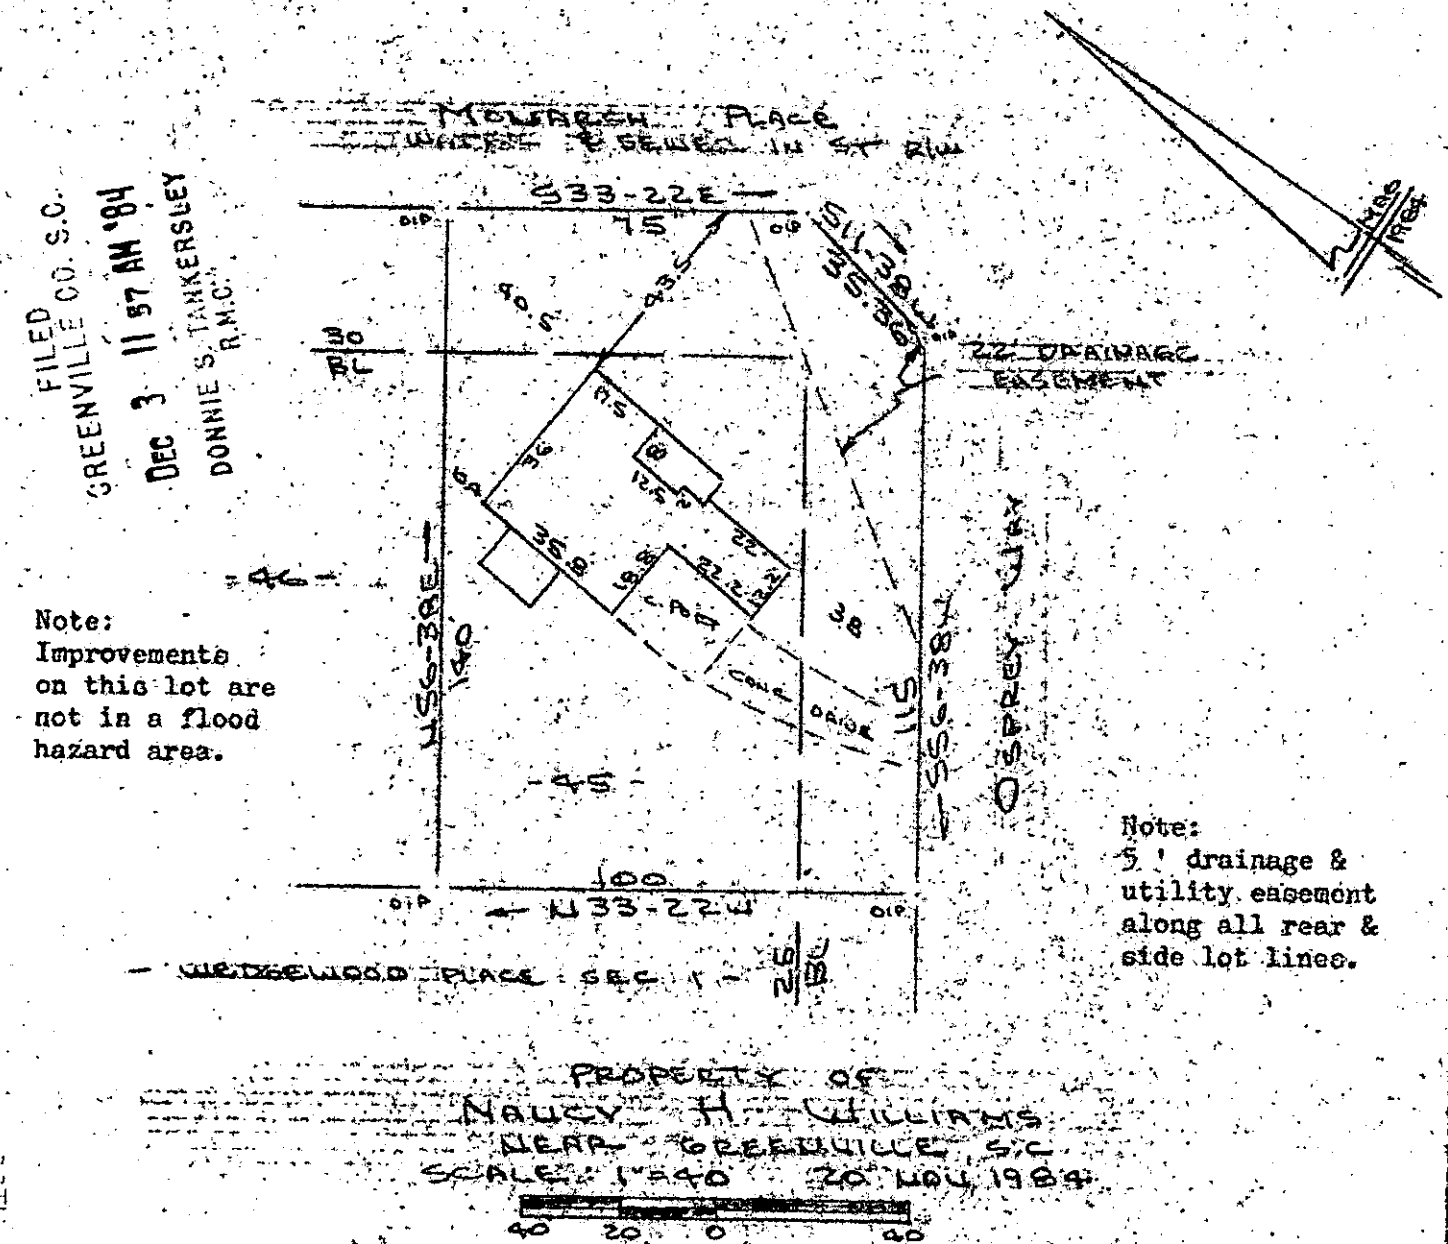

Note:
Improvements on this lot are not in a flood hazard area.

Note:
5' drainage & utility easement along all rear & side lot lines.

PROPERTY OF
NANCY H. WILLIAMS
NEAR GREENVILLE, S.C.
SCALE: 1"=40' 20 NOV. 1984
40 20 0 40

This is to certify that on the 20th day of November, 1984, I surveyed the property shown on this plat, being known as lot 45 on plat of SECTION 2 WEDGEWOOD PLACE and recorded in the R&C Office Greenville County, S. C., in Plat Book " 10 - H " at Page 21; and that the property lines, walls and buildings are as shown hereon, and that the walls and buildings located on said lot do not encroach or project on adjacent street or property, and that no adjacent walls or buildings encroach or project on said premises, and no power lines cross this property except as shown hereon.

DEC 3 1984

11D-4

16691

R. B. Bruce

R. B. Bruce, RLS # 1952

Recordable Plat

CAROLINA SURVEYING CO.
112 Manly St.
Greenville, S. C.

2 DE 84

348.

3.00CI

277/349