


FILED  
 GREENVILLE CO. S.C.  
 DEC 13 9 16 AM '84  
 DONNIE S. TANKERSLEY  
 R.M.C.



DEC 13 1984


11 D-38  
 17810

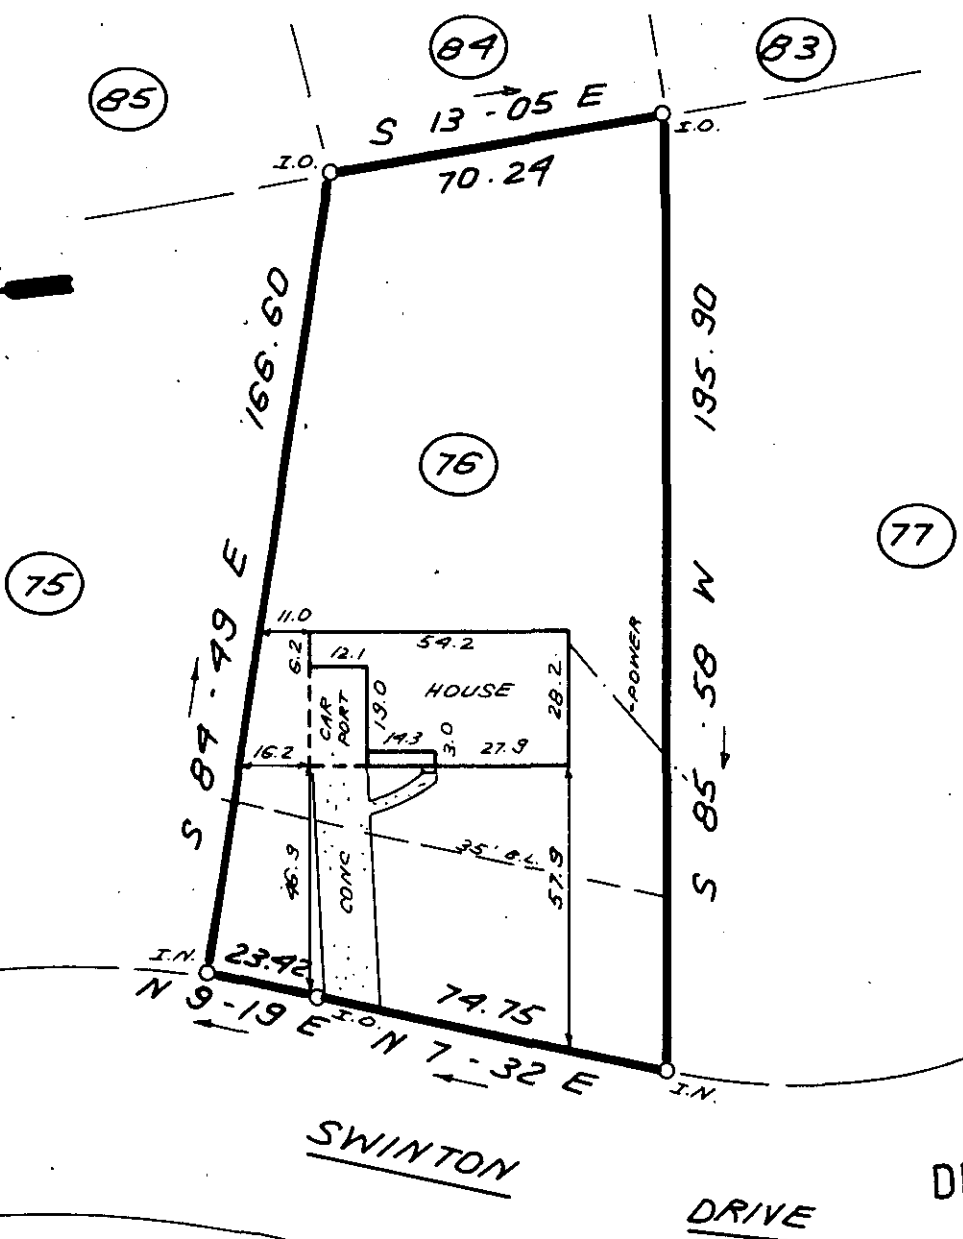

THIS IS TO CERTIFY THAT THE PROPERTY SHOWN ON THIS PLAT WAS SURVEYED UNDER MY DIRECT SUPERVISION PROPERTY LINES AND IMPROVEMENTS SHOWN ARE LOCATED CORRECTLY AND THAT NO VISIBLE ENCROACHMENTS EXIST UNLESS OTHERWISE SHOWN. THIS PROPERTY IS NOT LOCATED IN A DESIGNATED FLOOD HAZARD AREA

**STATE OF SOUTH CAROLINA  
 GREENVILLE COUNTY**

**FREELAND & ASSOCIATES**  
 Engineers • Land Surveyors  
 318 WEST STONE AVENUE.  
 GREENVILLE, S.C.  
 (803) 271-4924

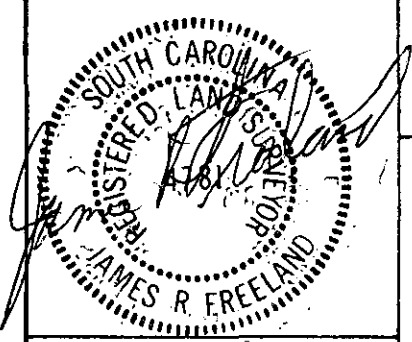

WINDSOR PARK  
LOT 76  
PROPERTY OF  
GERALD R. GLUR

PLAT BOOK	R.R @ 25
DEED BOOK	
TAX MAP	M 9.2-1-83
PARTY CHIEF	R.G.
DRAWN	K.E.G.
DATE	DEC. 13, 1984
DWG NO.	12183

RLS. JAMES R. FREELAND  
 NO: 4781

5010 -- 3 DE 13 84 '15 35