


PT. 308

FILED
GREENVILLE CO. S.C.

Dec 13 3 18 PM '84

DONNIE S. TANKERSLEY
R.M.C.

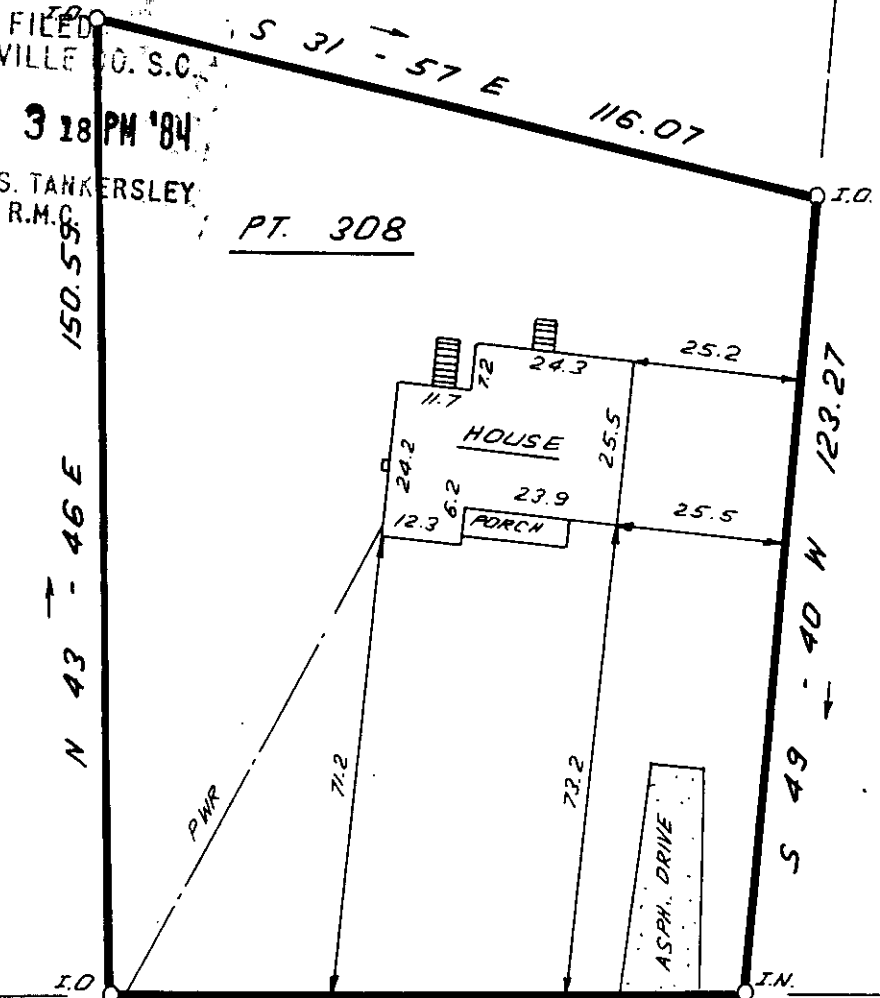

307

309

N 45 - 51 W 100.0


FRANKLIN ROAD

248.8' ± TO
PARKER ROAD


17868 ✓

11-D-43

DEC 13 1984

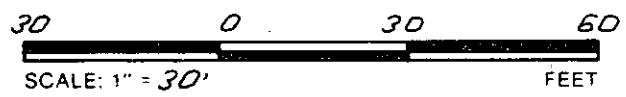

THIS IS TO CERTIFY THAT THE PROPERTY SHOWN ON THIS PLAT WAS SURVEYED UNDER MY DIRECT SUPERVISION PROPERTY LINES AND IMPROVEMENTS SHOWN ARE LOCATED CORRECTLY AND THAT NO VISIBLE ENCROACHMENTS EXIST UNLESS OTHERWISE SHOWN. THIS PROPERTY IS NOT LOCATED IN A DESIGNATED FLOOD HAZARD AREA

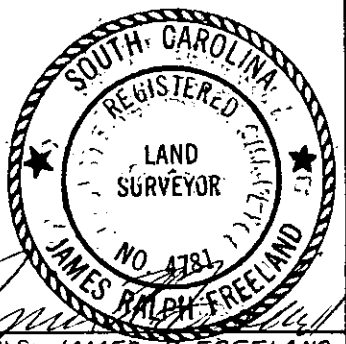

**STATE OF SOUTH CAROLINA
GREENVILLE COUNTY**

FREELAND & ASSOCIATES
Engineers • Land Surveyors
318 WEST STONE AVENUE.
GREENVILLE, S.C.
(803) 271-4924

COLONIA COMPANY PROP.

PART LOT 308
PROPERTY OF
DAVID M. HARDEN
DEBRA M. HARDEN

PLAT BOOK	J - 190 - 191
DEED BOOK	1153 - 579
TAX MAP	165 - 2 - 31
PARTY CHIEF	M.L.C
DRAWN	J.R.
DATE	12 - 11 - 84
DWG NO	12,194

RLS JAMES R. FREELAND
NO. 4781