


FILED
GREENVILLE CO. S.C.
DEC 18 1984 02 AM '84
DONNIE S. TAKKERSLEY
R.M.C.

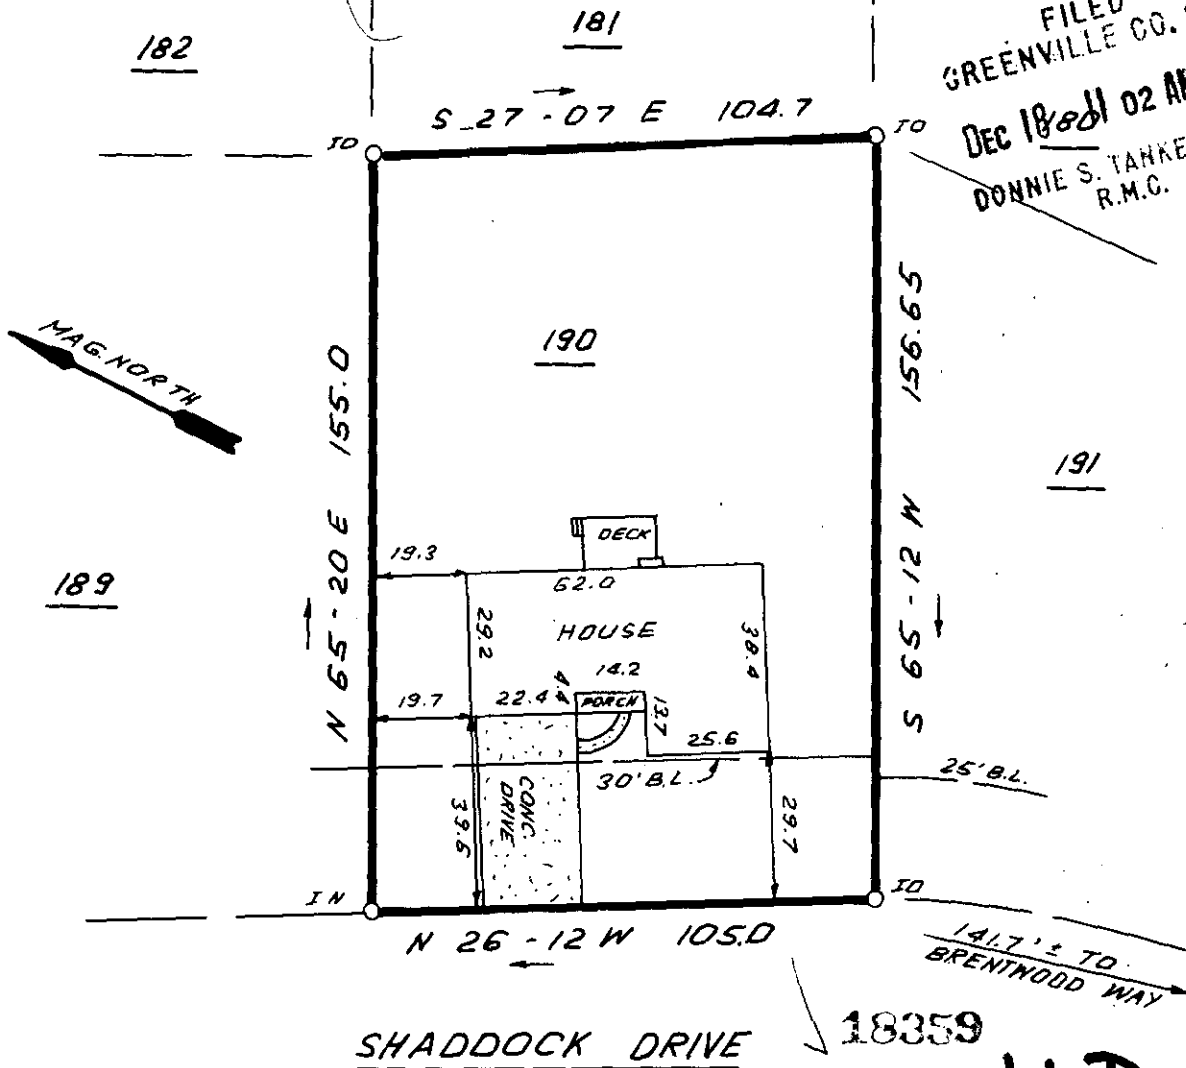


SHADDOCK DRIVE 18359

141.7' TO BRENTWOOD WAY

11D-57

DEC 18 1984

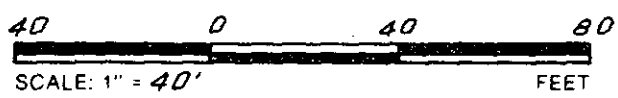

NOTE: 5' DRAINAGE & UTILITY EASEMENT EACH SIDE OF ALL SIDE & REAR LOT LINES, UNLESS OTHERWISE NOTED.

THIS IS TO CERTIFY THAT THE PROPERTY SHOWN ON THIS PLAT WAS SURVEYED UNDER MY DIRECT SUPERVISION. PROPERTY LINES AND IMPROVEMENTS SHOWN ARE LOCATED CORRECTLY AND THAT NO VISIBLE ENCROACHMENTS EXIST UNLESS OTHERWISE SHOWN. THIS PROPERTY IS NOT LOCATED IN A DESIGNATED FLOOD HAZARD AREA



STATE OF SOUTH CAROLINA
GREENVILLE COUNTY

FREELAND & ASSOCIATES
Engineers • Land Surveyors
318 WEST STONE AVENUE.
GREENVILLE, S.C.
(803) 271-4924

BRENTWOOD
SEC. IV, LOT 190
PROPERTY OF
FRANK A. GOODSON
MARSHA K. GOODSON

PLAT BOOK	50 - 43
DEED BOOK	
TAX MAP	319.2 - 1 - 118
PARTY CHIEF	B.G.
DRAWN	F.R.
DATE	12 - 14 - 84
DWG NO.	12 220001

RLS. JAMES R. FREELAND
NO: 4781

DEC 18 1984 474