

J.G. LOLLIS -
- 596.3-1-7 -

Note:
Improvements on this
lot are not in a
flood hazard area.

- DAVID GOSWELL -
- 596.3-1-4 -

FILED
GREENVILLE CO. S.C.


Dec 21 3 16 PM '84

DONNIE S. TANKERSLEY
R.M.C.

WILLIS CREAMER
- 596.1-1-15 -

RICHIEY ROAD
(WOODSIDE - SANDY SPRINGS ROAD)

PROPERTY OF
BOBBY E. SPAIN
NEAR GREENVILLE, GREENVILLE COUNTY, S.C.
SCALE: 1" = 50' 19 DEC 1983

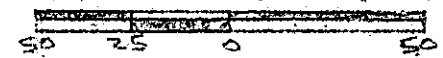

DEC 21 1984

11-D-69 18804

This is to certify that on the 19th day of December, 1984, I surveyed the property shown on this plat, being known as 1.19 acres as shown on an unrecorded plat, SURVEY FOR BOBBY SPAIN & WILLIS CREAMER dated February, 1984 by ROBERT H. JOHNSON, NO. 8103 and also known as PROPERTY OF BOBBY E. SPAIN and recorded in Plat Book at Page ; and that the property lines, walls and buildings are as shown hereon, and that the walls and buildings located on said lot do not encroach or project on adjacent street or property, and that no adjacent walls or buildings encroach or project on said premises, and no power lines cross this property except as shown hereon.

CAROLINA SURVEYING CO., 112 Main St., Greenville, S. C.

Recordable Plat 2184-1101
R. B. Bruce, RLS # 1952

MICROFILMED