


FILED
GREENVILLE CO. S.C.

Dec 28 4 49 PM '84

DONNIE S. TANKERSLEY
R.M.C.

NOW OR FORMERLY T.C. LEAGUE.

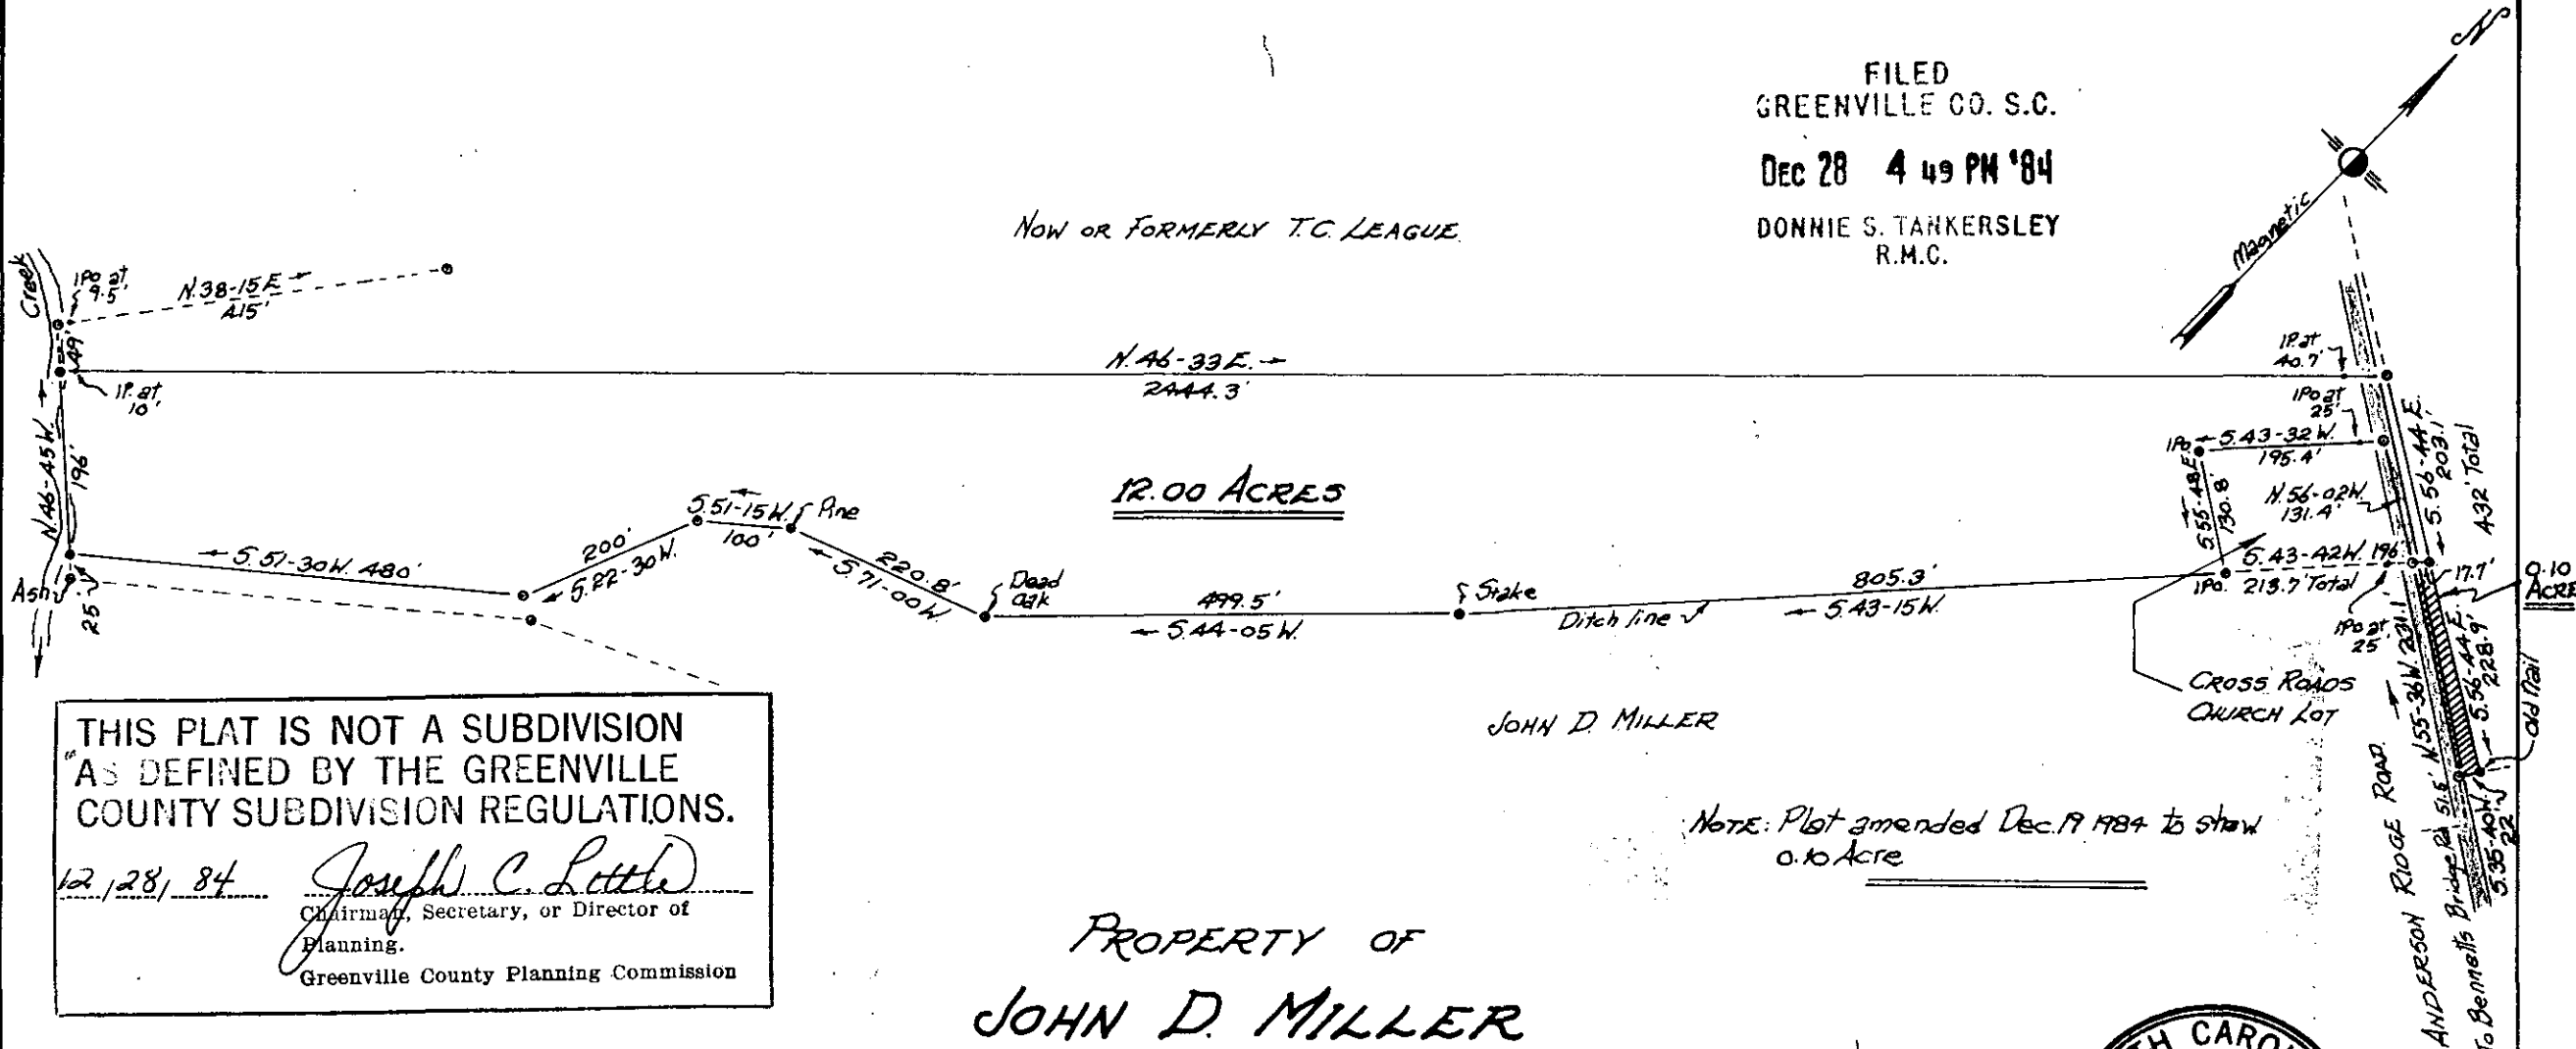

12.00 ACRES

JOHN D. MILLER

NOTE: Plot amended Dec. 19 1984 to show
0.10 acre

THIS PLAT IS NOT A SUBDIVISION
AS DEFINED BY THE GREENVILLE
COUNTY SUBDIVISION REGULATIONS.

12/28/84 *Joseph C. Little*
Chairman, Secretary, or Director of
Planning.
Greenville County Planning Commission

PROPERTY OF
JOHN D. MILLER

Located near Cross Roads Baptist Church.

GREENVILLE COUNTY,

SOUTH CAROLINA.

19396

SCALE: 1" = 200 FEET

FEB. 22 1980

11-D-90

DEC 28 1984



Tri-State Surveyors
109 Few Street

Greenville, S. C. 296513.0001



GCTC -- 3 DE28 84

MICROFILMED