


DEC 31 1984

FILED
GREENVILLE CO. S.C.
DEC 31 10 22 AM '84
DONNIE S. YAKERSLEY
R.M.C.




600' ± TO
HAZEL STREET I.O.

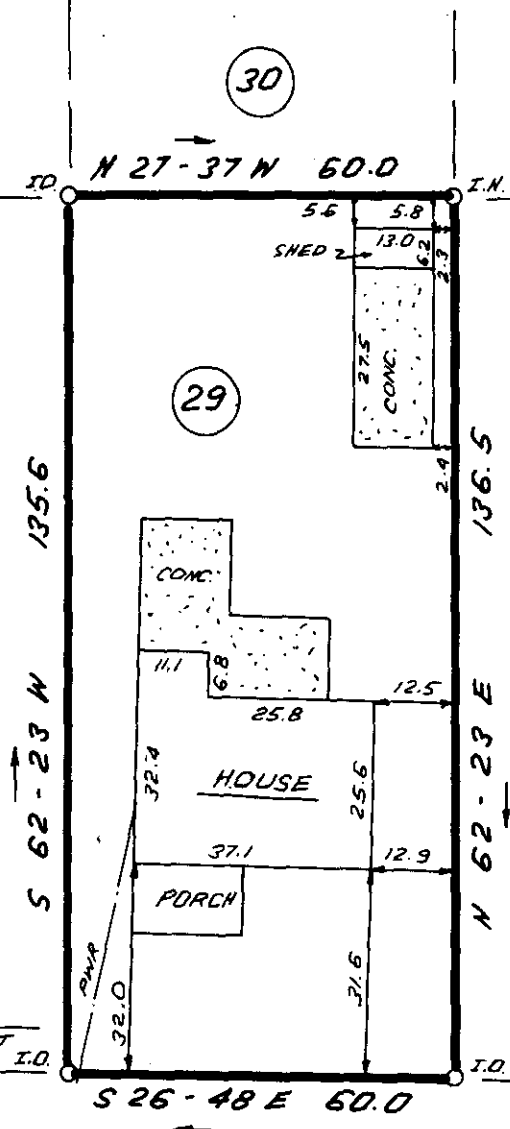

PINEHURST DRIVE

19513

11-D-91

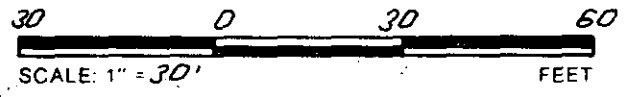

THIS IS TO CERTIFY THAT THE PROPERTY SHOWN ON THIS PLAT WAS SURVEYED UNDER MY DIRECT SUPERVISION PROPERTY LINES AND IMPROVEMENTS SHOWN ARE LOCATED CORRECTLY AND THAT NO VISIBLE ENCROACHMENTS EXIST UNLESS OTHERWISE SHOWN. THIS PROPERTY IS NOT LOCATED IN A DESIGNATED FLOOD HAZARD AREA

SOUTH CAROLINA
REGISTERED LAND SURVEYOR
4781
JAMES R. FREELAND

RLS JAMES R. FREELAND
NO: 4781

**STATE OF SOUTH CAROLINA
GREENVILLE COUNTY**

PINEHURST
LOT 29
PROPERTY OF
WILLIAM H. WATTS
PHYLLIS M. WATTS

FREELAND & ASSOCIATES
Engineers • Land Surveyors
318 WEST STONE AVENUE.
GREENVILLE, S.C.
(803) 271-4924

| | |
|-------------|-------------|
| PLAT BOOK | S-77-A |
| DEED BOOK | 559-475 |
| TAX MAP | P 15.6-2-29 |
| PARTY CHIEF | R.P. |
| DRAWN | I.R. |
| DATE | 12-27-84 |
| SWG NO | 12273 |