


EAST LEE ROAD

19511

11-D-92

FILED  
GREENVILLE CO. S.C.  
DEC 31 11 13 AM '84  
DONNIE S. TANKERSLEY  
R.M.C.

THIS IS TO CERTIFY THAT THE PROPERTY SHOWN ON THIS PLAT WAS SURVEYED UNDER MY DIRECT SUPERVISION. PROPERTY LINES AND IMPROVEMENTS SHOWN ARE LOCATED CORRECTLY AND THAT NO VISIBLE ENCROACHMENTS EXIST UNLESS OTHERWISE SHOWN. THIS PROPERTY IS NOT LOCATED IN A DESIGNATED FLOOD HAZARD AREA.

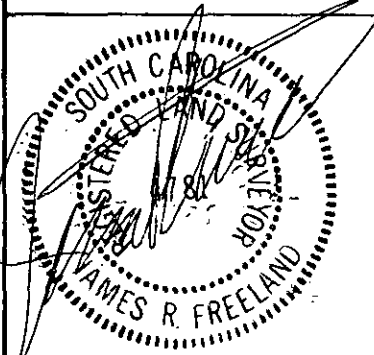

PLS: JAMES R. FREELAND  
NO: 4781

STATE OF SOUTH CAROLINA  
GREENVILLE COUNTY

PINEHURST  
BLOCK A; LOTS 1 & 2  
PROPERTY OF  
DR. GARY G. HARBIT  
CLAUDIA B. HARBIT

FREELAND & ASSOCIATES  
Engineers • Land Surveyors  
318 WEST STONE AVENUE.  
GREENVILLE, S.C.  
(803) 271-4924

PLAT BOOK	S @ 77A
DEED BOOK	866 - 599
TAX MAP	P 15.6 -1-1
PARTY CHIEF	J.C.
DRAWN	K.E.G.
DATE	DEC. 31, 1984
DWG. NO.	12282