


Note:
Improvements on
this lot are not
in a flood
hazard area.

MICROFILMED

FILED
GREENVILLE CO. S.C.
JAN 15 1985 44 PM '85
DONNIE S. WALKERSLEY
R.M.C.

AUGUSTA STREET

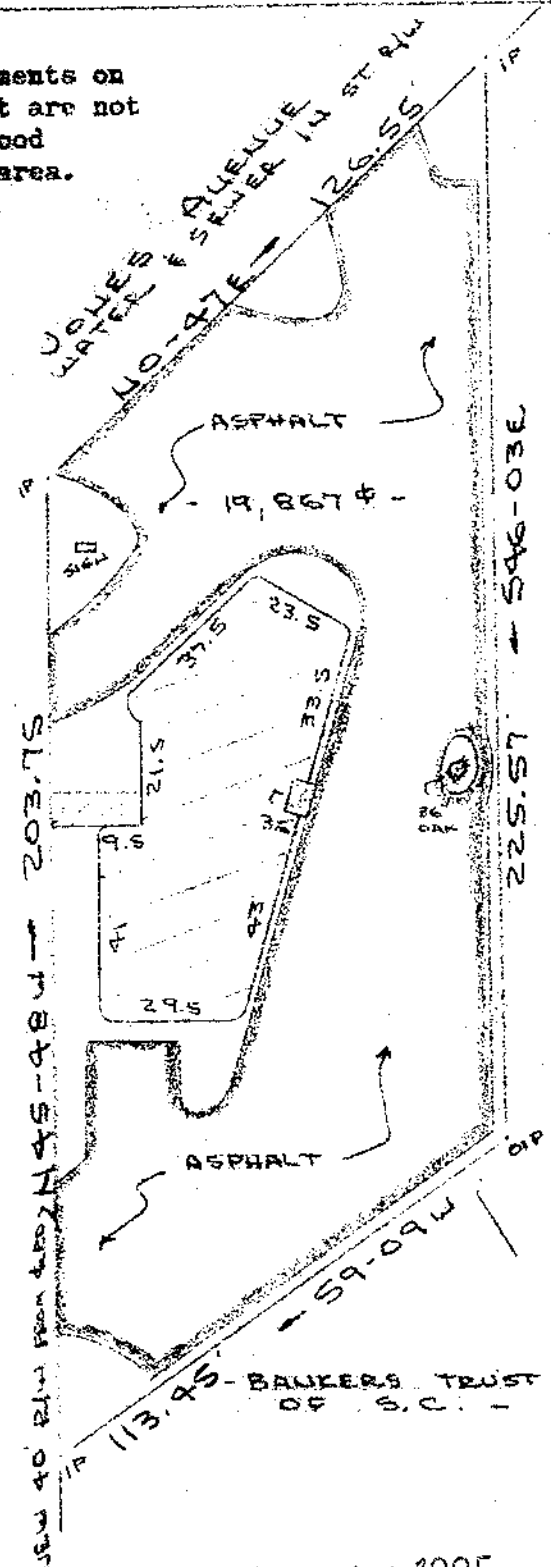

HUGH B. HAMILTON, JR.

PROPERTY OF
L. STEWART SPINKS
GREENVILLE COUNTY,
GREENVILLE, S.C.
SCALE: 1" = 40' 10 JAN 1985

This is to certify that on the 10th day of January, 1985, I surveyed the property shown on this plat, being known as PROPERTY OF L. STEWART SPINKS and recorded in the RMC Office Greenville County, S. C., in Plat Book at Page ; and that the property lines, walls and buildings are as shown hereon, and that the walls and buildings located on said lot do not encroach or project on adjacent street or property, and that no adjacent walls or buildings encroach or project on said premises, and no power lines cross this property except as shown hereon.

R. B. Bruce
R. B. Bruce, RLS # 1952

JAN 15 1985

21051

Recordable Plat

11E-39

CAROLINA SURVEYING CO.
112 Manly St.
Greenville, S. C.

GCFO -----1 JAN 15 85 014

3.00CD

282/37

27-S-72