


MICROFILM

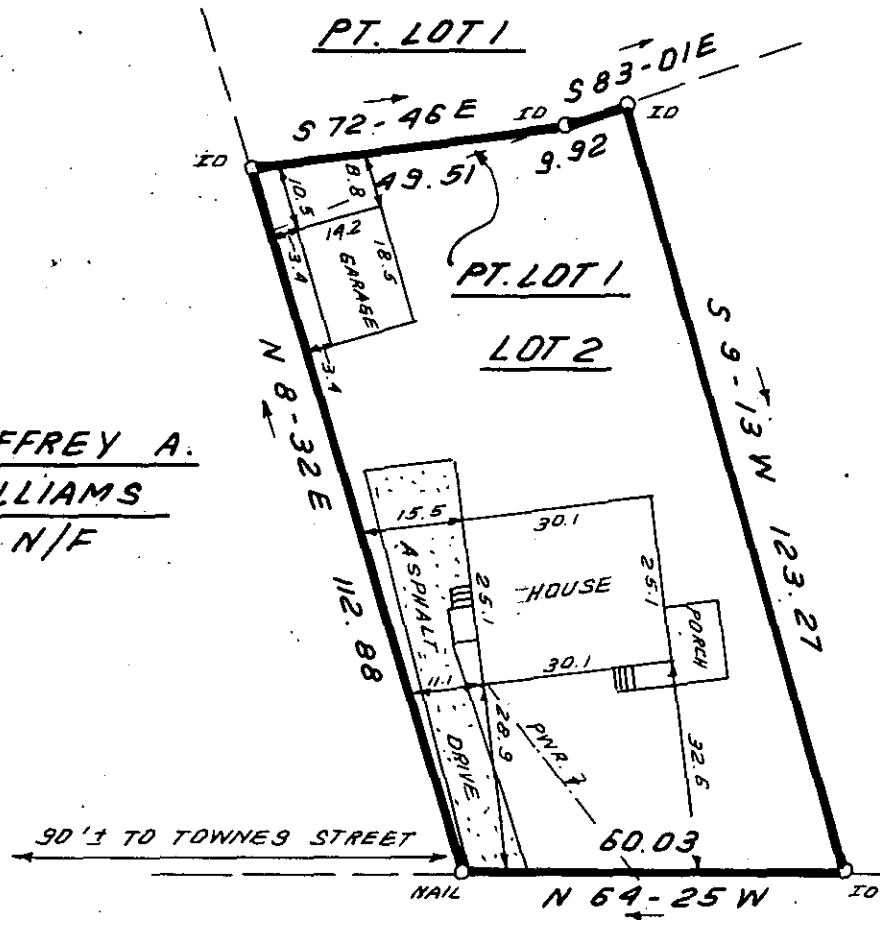


JEFFREY A.
WILLIAMS
N/F

FILED
GREENVILLE CO. S.C.
JAN 15 4 26 PM '85
DONNIE S. TARKERSLEY
R.M.C.

ASHLEY AVENUE

21054 ✓

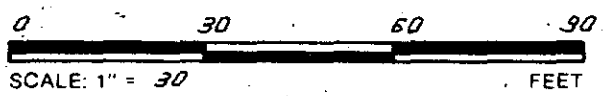

11-E-41

THIS IS TO CERTIFY THAT THE PROPERTY SHOWN ON THIS PLAT WAS SURVEYED UNDER MY DIRECT SUPERVISION. PROPERTY LINES AND IMPROVEMENTS SHOWN ARE LOCATED CORRECTLY AND THAT NO VISIBLE ENCROACHMENTS EXIST UNLESS OTHERWISE SHOWN. THIS PROPERTY IS NOT LOCATED IN A DESIGNATED FLOOD HAZARD AREA

SOUTH CAROLINA
REGISTERED LAND SURVEYOR
4781
JAMES R. FREELAND

RLS: JAMES R. FREELAND
NO: 4781

**STATE OF SOUTH CAROLINA
GREENVILLE COUNTY**

BUIST CIRCLE
PT. LOT 1 & LOT 2
BLOCK "F"
PROPERTY OF
MICHAEL G. ROSENSTEEL

FREELAND & ASSOCIATES Engineers • Land Surveyors 318 WEST STONE AVENUE. GREENVILLE, S.C. (803) 271-4924
PLAT BOOK C@10; 10R-25
DEED BOOK 1156-152
TAX MAP 178-11-26
PARTY CHIEF J.E.C.
DRAWN B.R.
DATE 1-11-85
DWG. NO. 12, 329

2 JAN 1985 1047 3.0001