
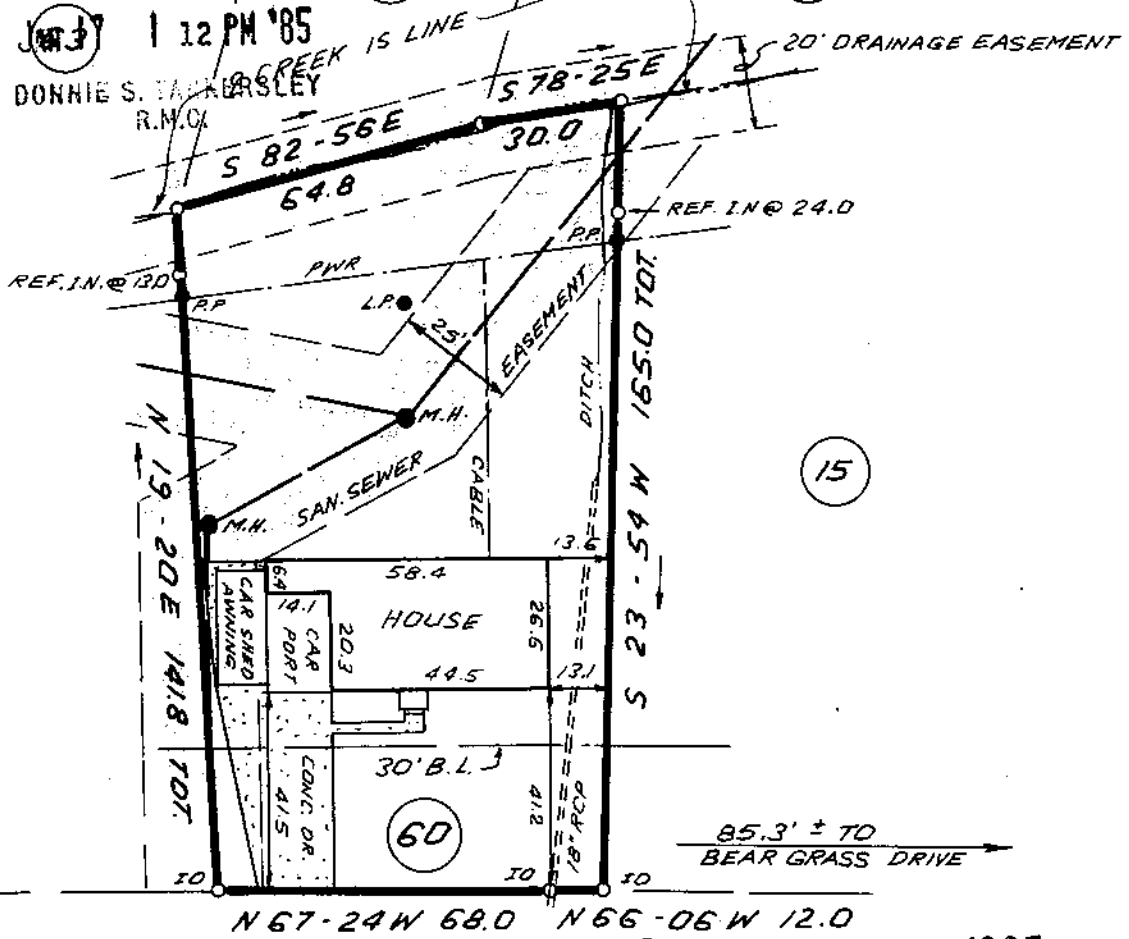


FILED
GREENVILLE CO/S.C.

62

61

JAN 17 12 PM '85
DONNIE S. TARKER
R.M.C.

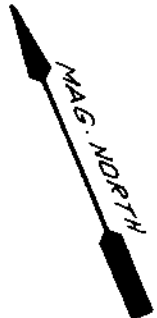

59

15

JAN 17 1985

KATHRYAN COURT

21247
11-E-51



NOTE: 5' DRAINAGE & UTILITY EASEMENT ALONG ALL SIDE & REAR LOT LINES, ON CREEK & BRANCH 10' EACH SIDE.

THIS IS TO CERTIFY THAT THE PROPERTY SHOWN ON THIS PLAT WAS SURVEYED UNDER MY DIRECT SUPERVISION PROPERTY LINES AND IMPROVEMENTS SHOWN ARE LOCATED CORRECTLY AND THAT NO VISIBLE ENCROACHMENTS EXIST UNLESS OTHERWISE SHOWN THIS PROPERTY IS LOCATED IN A DESIGNATED FLOOD HAZARD AREA

RLS: JAMES R. FREELAND
NO: 4781

**STATE OF SOUTH CAROLINA
GREENVILLE COUNTY**

CHESTNUT HILLS NO. I
LOT 60
PROPERTY OF
MICHAEL A. GING
SHERYL A. BRUBAKER

FREELAND & ASSOCIATES
Engineers • Land Surveyors
318 WEST STONE AVENUE.
GREENVILLE S.C.
(803) 271-4924

PLAT BOOK	QQ - 83
DEED BOOK	1037 - 520
TAX MAP	216-102-2-295
PARTY CHIEF	B.G.
DRAWN	I.R.
DATE	1-15-85
DWG NO	12,340

GC10 - 1 JAN 17 85 023 3.00CD