


MC SWAIN (26-9-3)

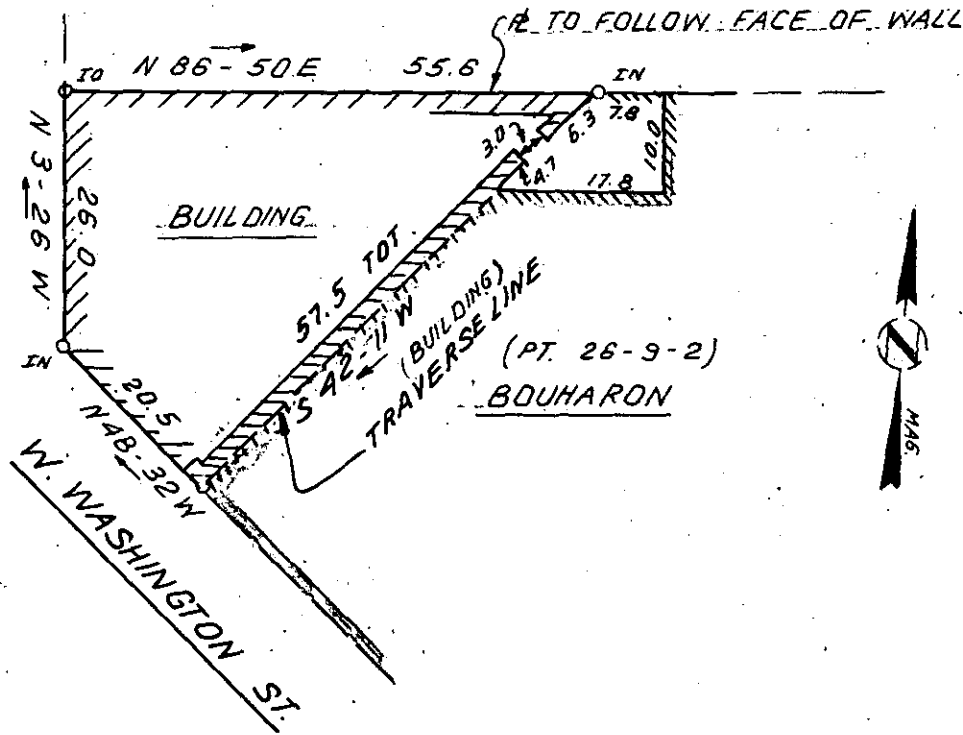

FILED JAN 17 1985
 GREENVILLE CO. S.C.
 JAN 17 2 05 PM '85
 DONNIE S. TANKERSLEY
 R.M.C.

This is to certify that on Aug. 24, 1984, I surveyed the property shown on this plat, known as Property of Eugenia A.K. Manos, recorded in the RMC Office of Greenville County in Deed Book 245 on page 362, and that the property lines, walls and buildings are as shown hereon; that the building located on said property does not encroach or project on adjacent streets or property, and that no adjacent walls or buildings encroach or project on said premises, and that no utility lines cross this property except as shown hereon. This property is not located in a designated flood hazard area.


11-E-52

21292 ✓

James R. Freeland
 James R. Freeland RLS & PE 4781



JAN 17 1985

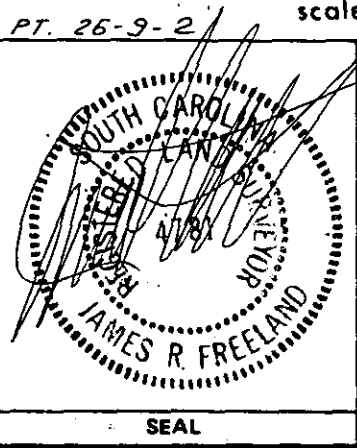

**STATE OF SOUTH CAROLINA
 GREENVILLE COUNTY**

PROPERTY OF
PETER SASSO

FREELAND & ASSOCIATES Engineers • Land Surveyors	
GREENVILLE, S.C.	
SURVEY	J.C.
DRAWN	BR
CHECK	MLC
SCALE	1" = 20'
DATE	8-24-84
DWG. NO.	11,676

PRINT MACHINE INC. 048 817 85