


- N/A A. H. PITTMAN -

Note: Improvements on this lot are not in a flood hazard area.

PROPERTY OF
 JAMES W HAMMOND & TERESA B HAMMOND
 HBAR GREENVILLE, S.C.
 SCALE: 1" = 100'

FILED
 GREENVILLE CO. S.C.
 JAN 25 9 19 AM '85
 DONNIE S. TANKESELEY
 R.M.C.

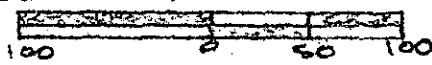

ECTD -----1 JAN 25 85 008 3.00CD

This is to certify that on the 8th day of January, 1985, I surveyed the property shown on this plat, being known as lot 14 on plat of HOLLY HILL ESTATES and recorded in the REC Office Greenville County, S. C., in Plat Book "BBB" at Page 167; and that the property lines, walls and buildings are as shown hereon, and that the walls and buildings located on said lot do not encroach or project on adjacent street or property, and that no adjacent walls or buildings encroach or project on said premises, and no power lines cross this property except as shown hereon.

11-E-73

22054

JAN 25 1985

R. B. Bruce
 R. B. Bruce, R.S. # 1952

Recordable Plat

CAROLINA SURVEYING CO.
 112 Hanly St.
 Greenville, S. C.