

MICROFILMED

ALLEY



N 27-00 E 78.0

N 63-00 W 173.0

S 63-00 E 173.0

S 27-00 W 78.0

CONESTEE AVENUE


PART 39

PART 39

38

37

FILED
GREENVILLE 60. S.C.
JAN 25 9 57 AM '85
BONNIE S. TANKERSLEY
R.M.S.

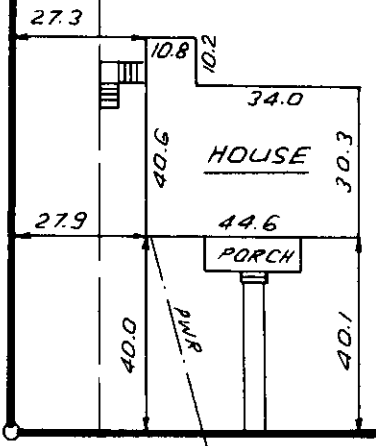

250' ± TO
SALUDA AVE. / ELSIE ST.



JAN 25 1985 ✓
11-E-74 22055

THIS IS TO CERTIFY THAT THE PROPERTY SHOWN ON THIS PLAT WAS SURVEYED UNDER MY DIRECT SUPERVISION PROPERTY LINES AND IMPROVEMENTS SHOWN ARE LOCATED CORRECTLY AND THAT NO VISIBLE ENCROACHMENTS EXIST UNLESS OTHERWISE SHOWN. THIS PROPERTY IS NOT LOCATED IN A DESIGNATED FLOOD HAZARD AREA.

SOUTH CAROLINA
REGISTERED LAND SURVEYOR
4781
JAMES R. FREELAND

RLS: JAMES R. FREELAND
NO: 4781

STATE OF SOUTH CAROLINA
GREENVILLE COUNTY

SOUTH CHEROKEE PARK
LOT 38 & PART LOT 39
PROPERTY OF
JAY L. DAVIS
MARGARET L. DAVIS

FREELAND & ASSOCIATES
Engineers • Land Surveyors
318 WEST STONE AVENUE,
GREENVILLE, S.C.
(803) 271-4924

PLAT BOOK	A - 130
DEED BOOK	1190 - 855
TAX MAP	218 - 6 - 5
PARTY CHIEF	B.G.
DRAWN	J.R.
DATE	1 - 17 - 85
DWG NO	12350