


FILED
 GREENVILLE CO. S.C.
 JAN 29 10 09 AM '85
 DONNIE S. TAKKERSLEY
 R.M.C.

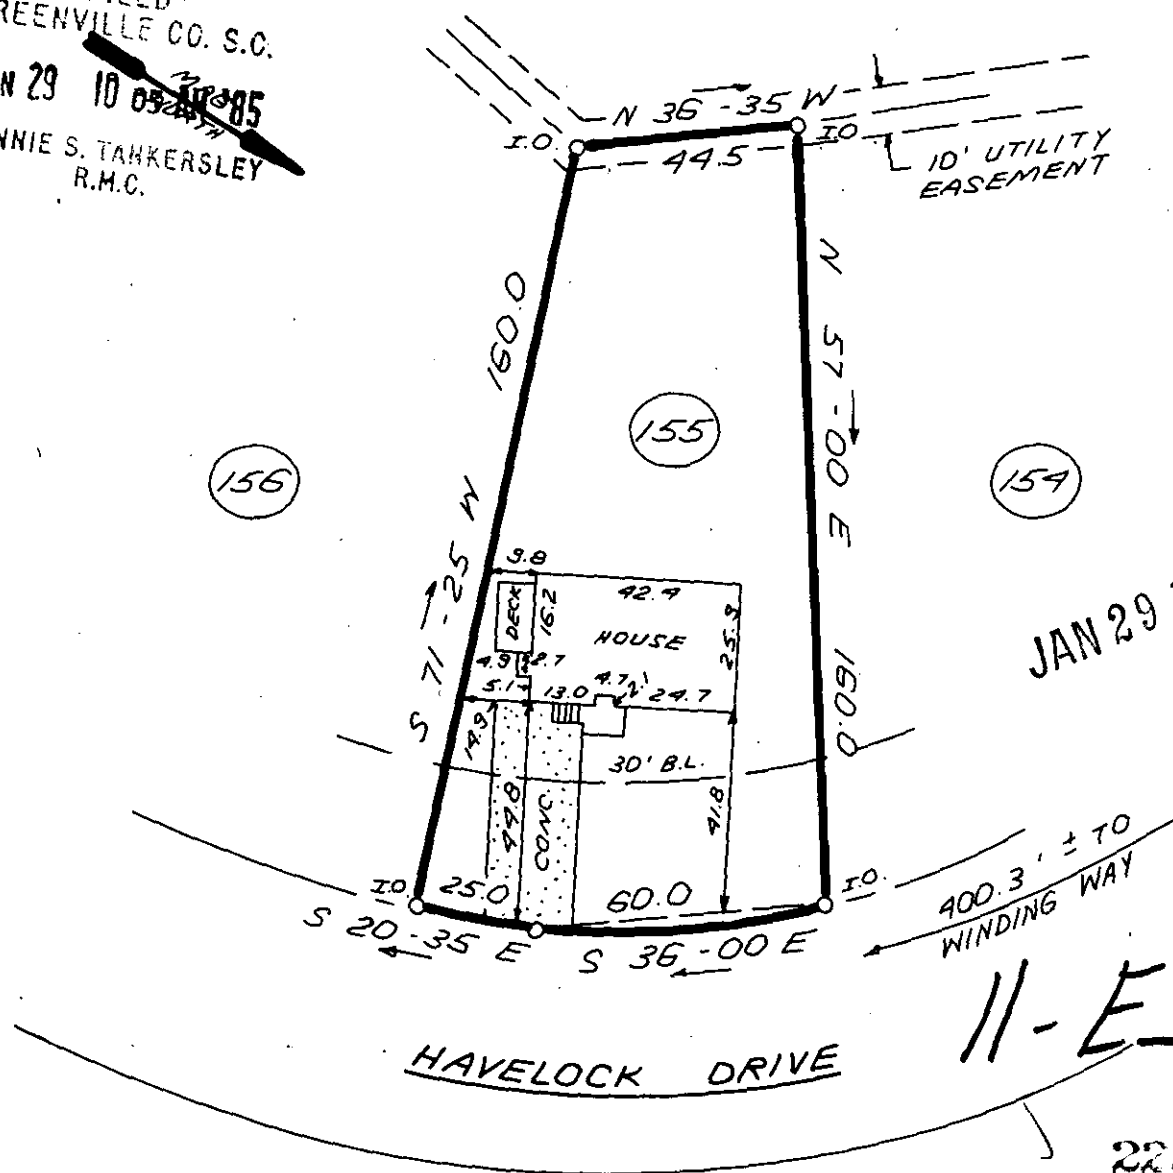

JAN 29 1985

11-E-82

22369



NOTE: THERE IS A 5' DRAINAGE & UTILITY EASEMENT EACH SIDE ALL SIDE & REAR LOT LINES UNLESS SHOWN OTHERWISE.

THIS IS TO CERTIFY THAT THE PROPERTY SHOWN ON THIS PLAT WAS SURVEYED UNDER MY DIRECT SUPERVISION. PROPERTY LINES AND IMPROVEMENTS SHOWN ARE LOCATED CORRECTLY AND THAT NO VISIBLE ENCROACHMENTS EXIST UNLESS OTHERWISE SHOWN THIS PROPERTY IS NOT LOCATED IN A DESIGNATED FLOOD HAZARD AREA

SOUTH CAROLINA
 REGISTERED LAND SURVEYOR
 4781
 JAMES R. FREELAND

RLS: JAMES R. FREELAND
 NO: 4781

STATE OF SOUTH CAROLINA
GREENVILLE COUNTY

PEPPERTREE
SEC. 3, LOT 155
PROPERTY OF
ROGER C. WEDEMEYER

FREELAND & ASSOCIATES
 Engineers • Land Surveyors
 318 WEST STONE AVENUE.
 GREENVILLE, S.C.
 (803) 271-4924

PLAT BOOK	4X @ 9
DEED BOOK	1132 @ 384
TAX MAP	7 27.1 -1- 213
PARTY CHIEF	J.C.
DRAWN	K.E.G.
DATE	JAN. 22, 1985
DWG NO.	12362

GC10 -----1 JA29 85 025 3.00CD