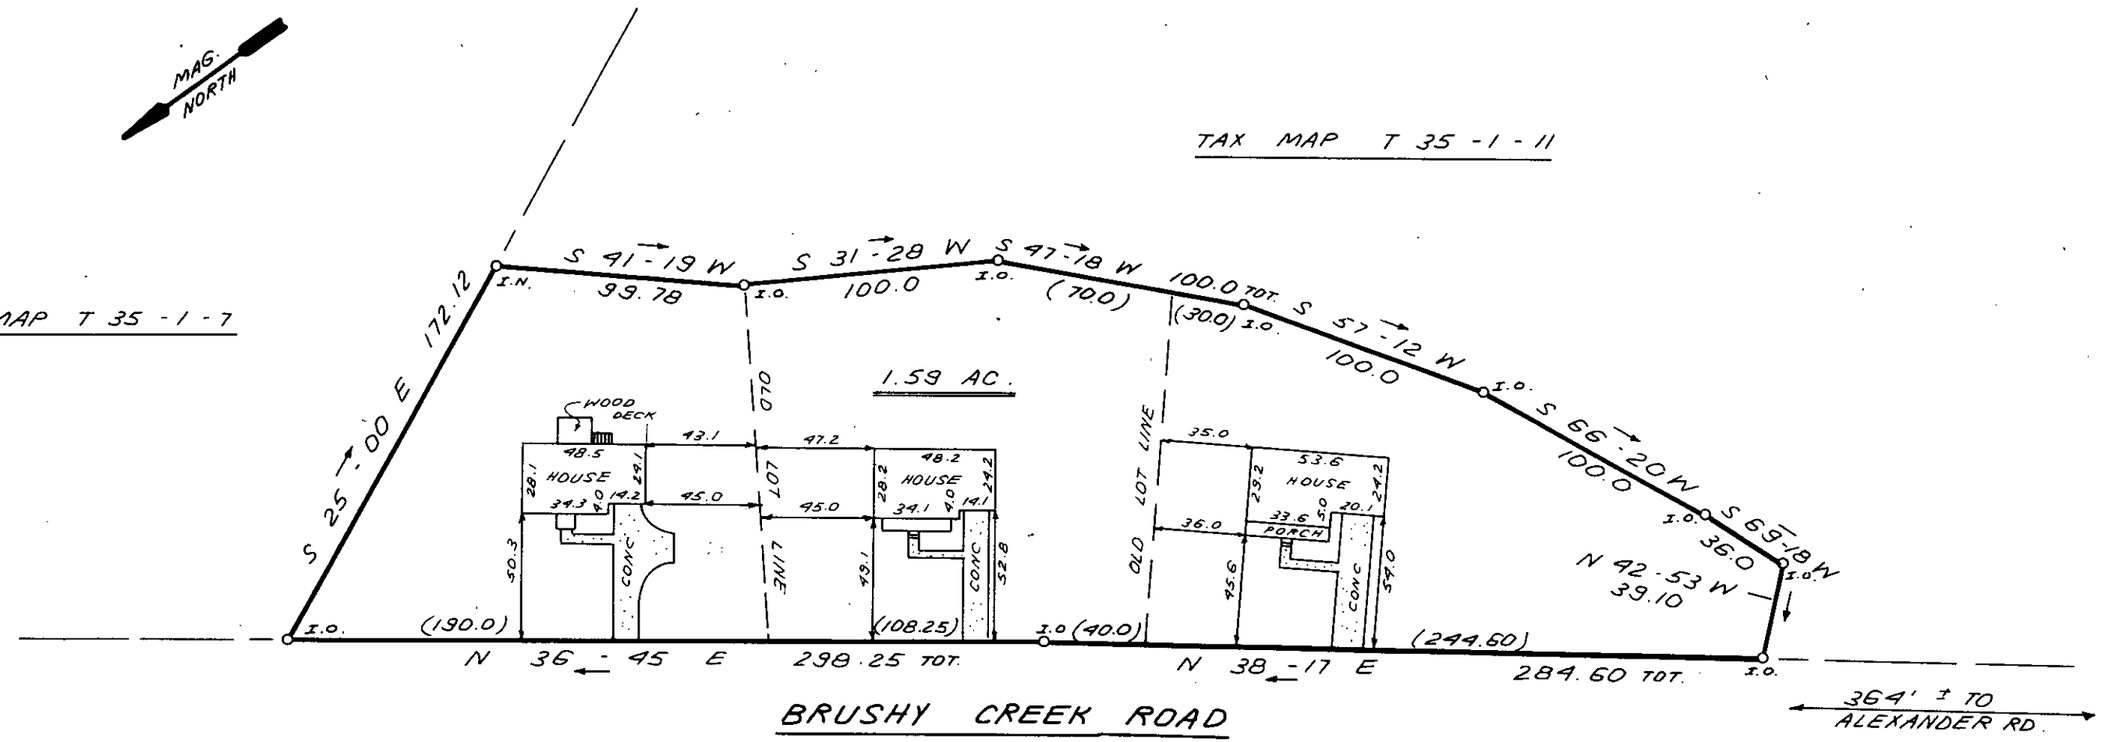

24855

FEB 22 1985

60 0 60 120

SCALE 1" 60' FEET

11-F-59

THIS IS TO CERTIFY THAT THE PROPERTY SHOWN ON THIS PLAT WAS SURVEYED UNDER MY DIRECT SUPERVISION PROPERTY LINES AND IMPROVEMENTS SHOWN ARE LOCATED CORRECTLY AND THAT NO VISIBLE ENCROACHMENTS EXIST UNLESS OTHERWISE SHOWN. THIS PROPERTY IS NOT LOCATED IN A DESIGNATED FLOOD HAZARD AREA.

SOUTH CAROLINA REGISTERED LAND SURVEYOR 4781 JAMES R. FREELAND

RLS: JAMES R. FREELAND
NO: 4781

STATE OF SOUTH CAROLINA
GREENVILLE COUNTY

SURVEY FOR

CHARLES D. ATKINSON

GCTO -- 3 FE22 85

FREELAND & ASSOCIATES
Engineers • Land Surveyors
318 WEST STONE AVENUE.
GREENVILLE, S.C.
(803) 271-4924

PLAT BOOK	10 0@ 5, 66 & 67
DEED BOOK	1208 - 243
TAX MAP	T 35 - 1 - 11.1
PARTY CHIEF	J.C.C.
DRAWN	K.E. G5.00CI
DATE	2 - 18 - 85
DWG. NO.	12475

FILED
GREENVILLE CO. S.C.
FEB 22 3 39 PM '85
DONNIE S. TANKERSLEY
R.M.C.

THE PRINT MACHINE, INC. N41289
MICROFILMED