


FILED
 GREENVILLE CO. S.C.
 APR 3 4 11 PM '85
 DONNIE S. YANKERSLEY
 R.M.C.

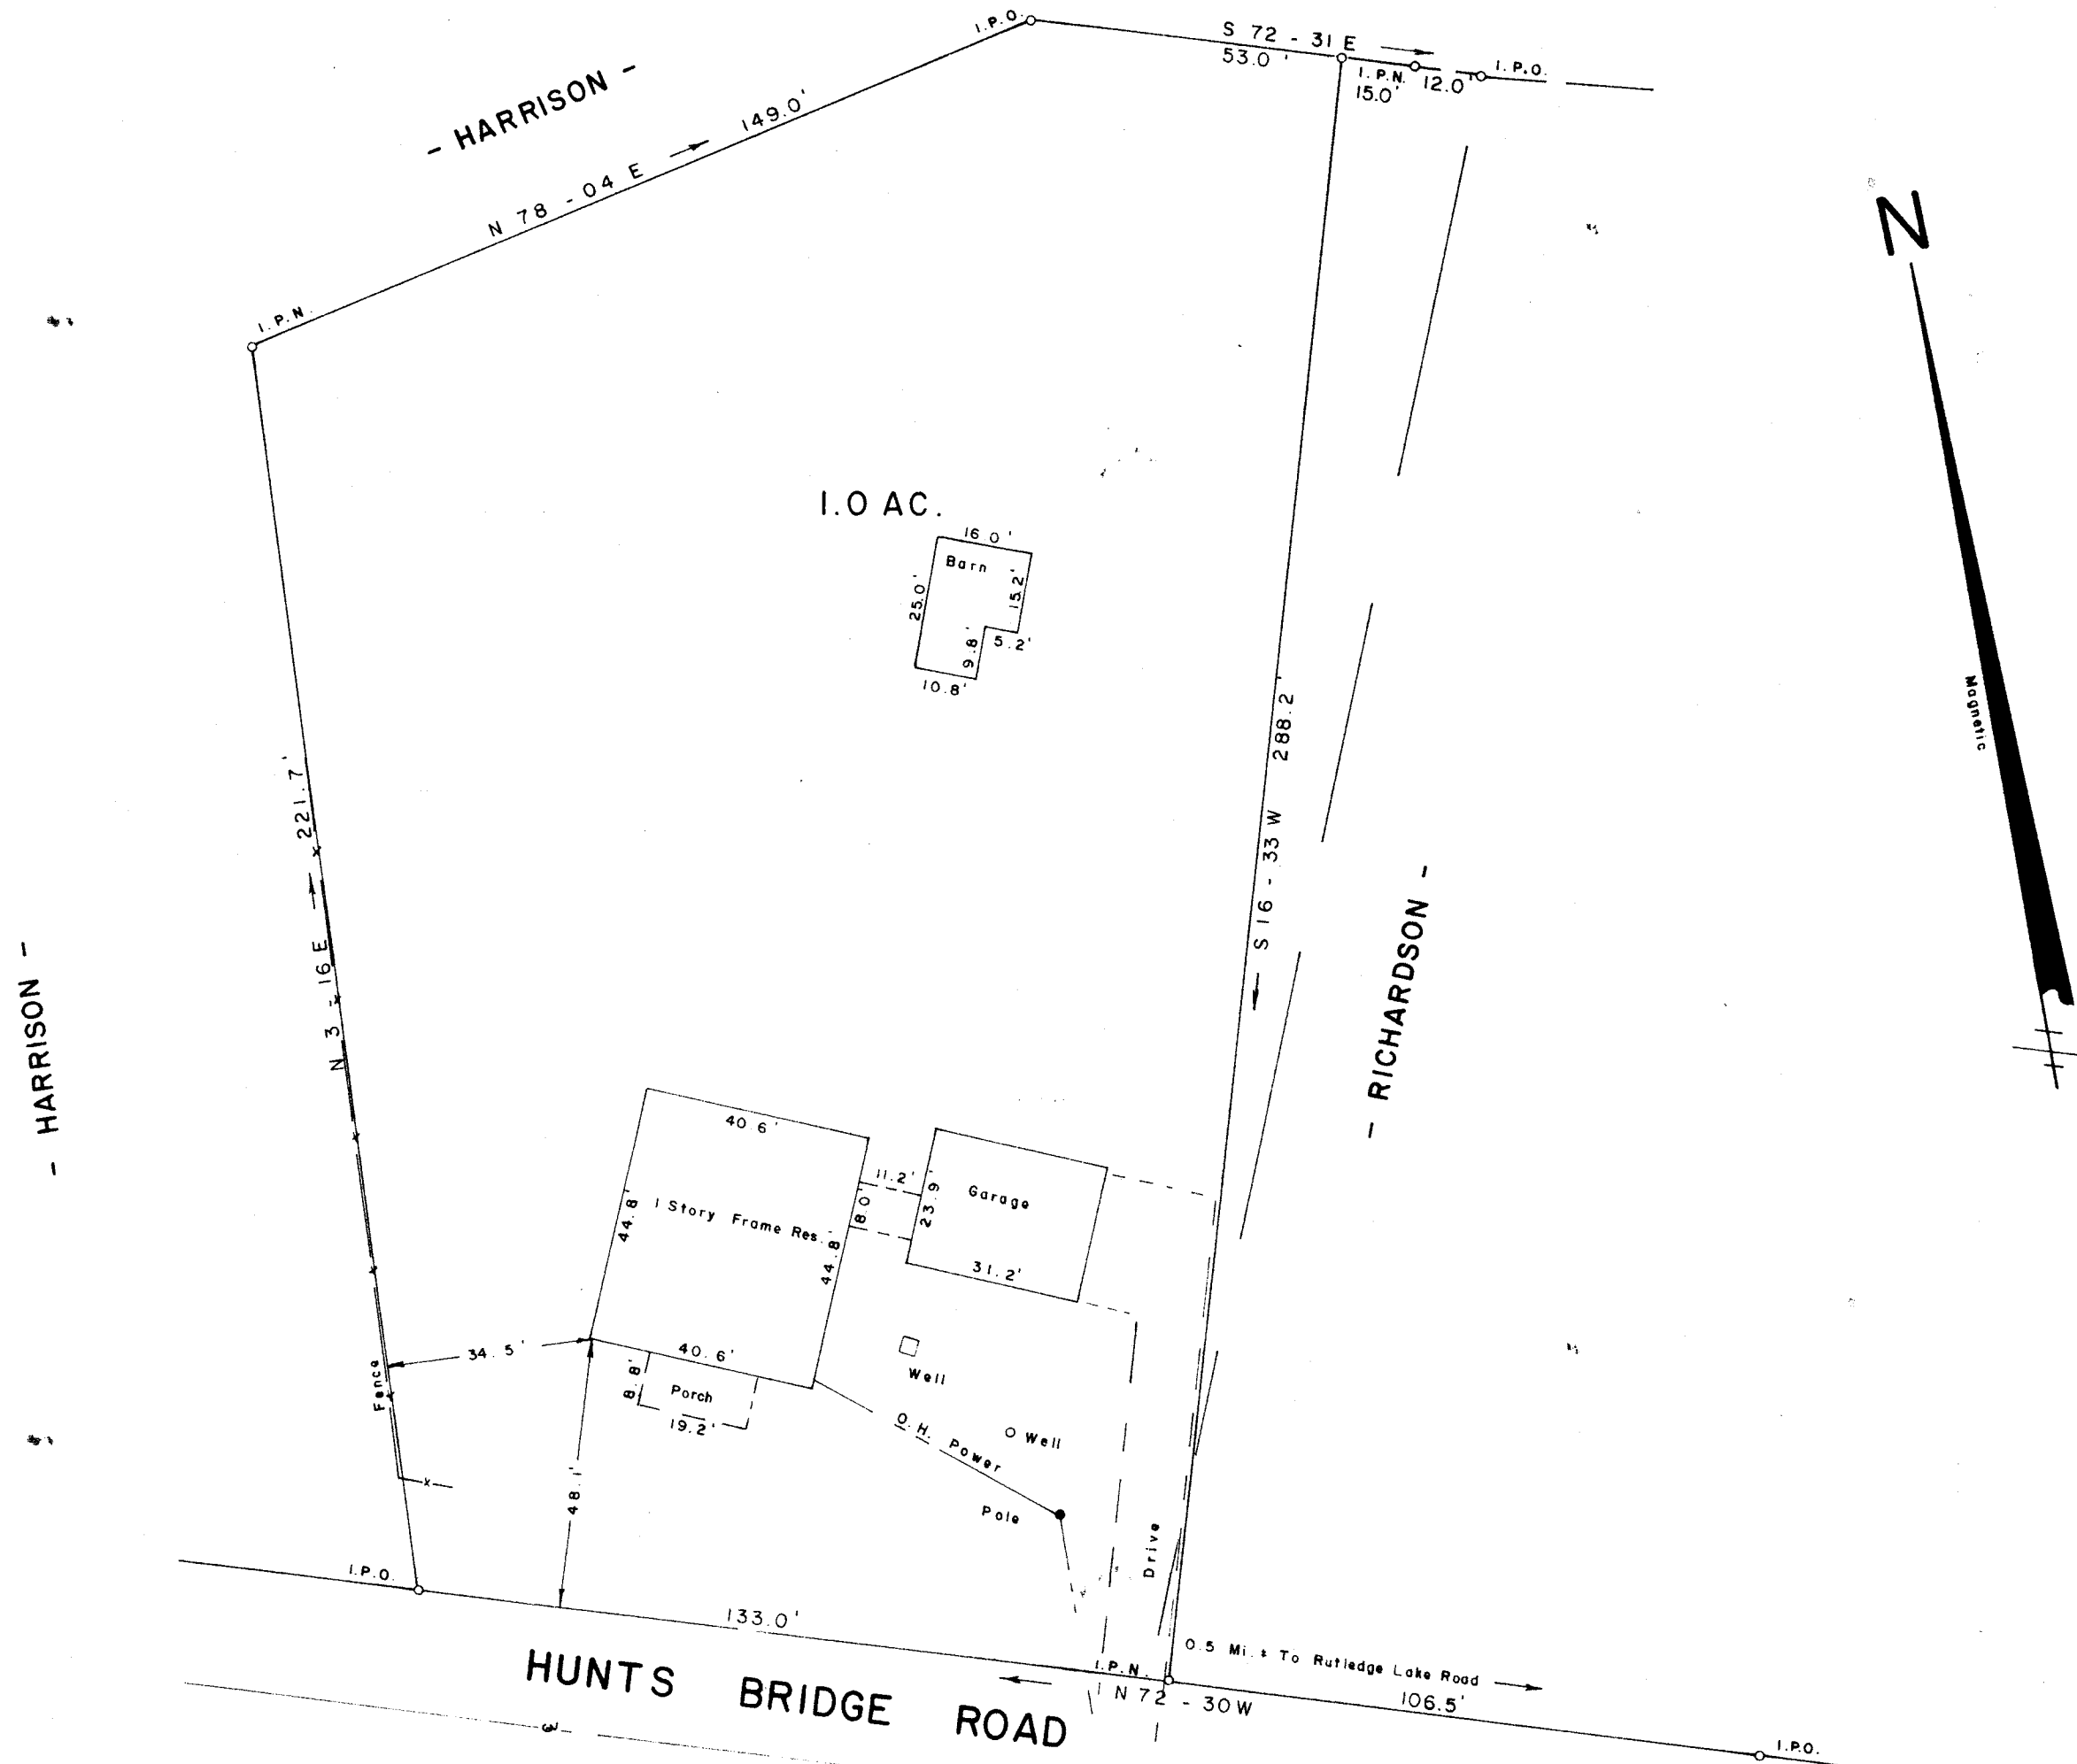

Note:
 Reference Plat By J. Mac Richardson,
 Dated Nov. 1966.

To The Best Of My Knowledge This Structure
 Is Not In An Established Flood Zone

JEFFERY M. PLUMBLEE, INC.
 LAND SURVEYING

P. O. BOX 788
 TRAVELERS REST, S. C. 29690 (803) 834-4426

SURVEY FOR
WILLIAM A. REEVES
MARY E. REEVES
 NEAR TRAVELERS REST GREENVILLE COUNTY
 SOUTH CAROLINA
 MARCH 29, 1985


APR 3 1985
 11 G-63

29625

I Hereby Certify That The Measurements As
 Shown Above Are Correct And There Are No
 Encroachments Or Projections Other Than
 Shown

I Hereby Certify That The Ratio Of Precision
 Of The Field Survey is 1:5000 As
 Shown Hereon And The Same Was Determined
 By D. W. D. Method

Jeffery M. Plumblee
 SURVEYOR

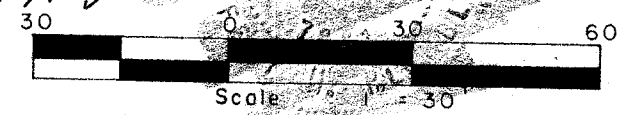

MICROFILMED