

MAG 1975


PINEY GROVE ROAD
WATER & SEWER 11 5T R/W

FILED
GREENVILLE CO. S.C.
FEB 12 4 26 PM '85
DONNIE S. TANKERSLEY
R.M.C.

REVESTED AREA
FORRESTER WOODS

Note:
5' drainage
& utility
easement along
all side and
rear lot lines.


Note: Improvements on
this lot are not in a
flood hazard area.

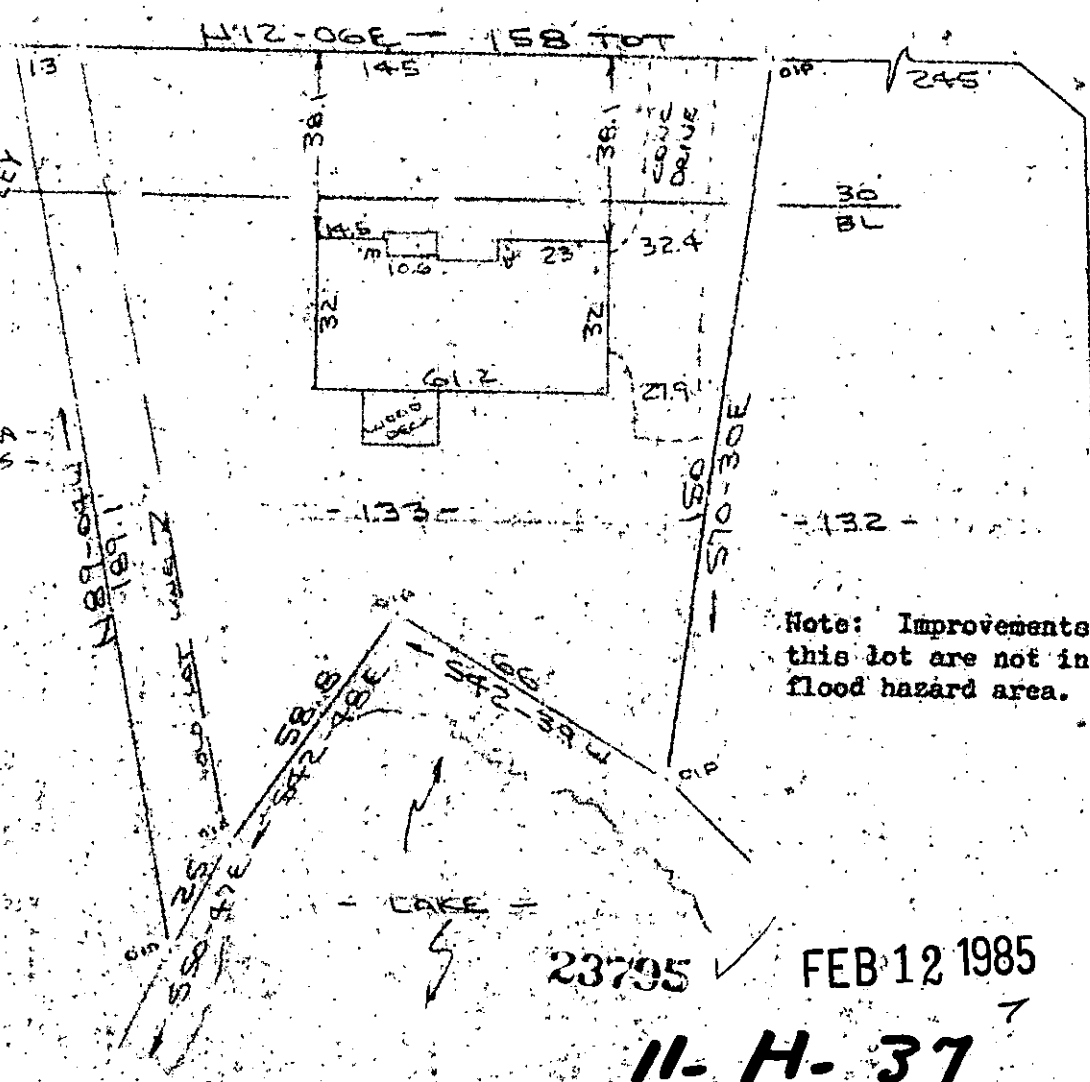

23795 FEB 12 1985

11-H-37

PROPERTY OF
MICHAEL A. ROBERTS & NANCY C. ROBERTS
GREENVILLE COUNTY MAUGONIN S.E.
SCALE 1"=40' FEB 1985

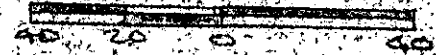

This is to certify that on the 12th day of February, 1985, I surveyed the property shown on this plat, being known as lot 133 on plat of SECTION 7 FORRESTER WOODS (Sheet 2 of 2) and recorded in the REC Office Greenville County, S. C., in Plat Book "5 - P" at Pgs. 21 & 22 and also plat of DANCO INC. and recorded in Plat Book "8 - Y" at Page 69 and also known as PROPERTY OF MICHAEL A. ROBERTS & NANCY C. ROBERTS and recorded in Plat Book _____ at Page _____; and that the property lines, walls and buildings are as shown hereon, and that the walls and buildings located on said lot do not encroach or project on adjacent street or property, and that no adjacent walls or buildings encroach or project on said premises, and no power lines cross this property except as shown hereon.

R. B. Bruce
R. B. Bruce, RLS # 1952

CAROLINA SURVEYING CO.
112 Main St.
Greenville, S.C.

Recordable Plat R. B. Bruce
(1350-6) (12485)

GC10 - 1 FEB 12 85 041

5:00 P.M.

222/44

M97-1-227