


JAMES A. K. ROPER

N 66-15-28 W 100.0

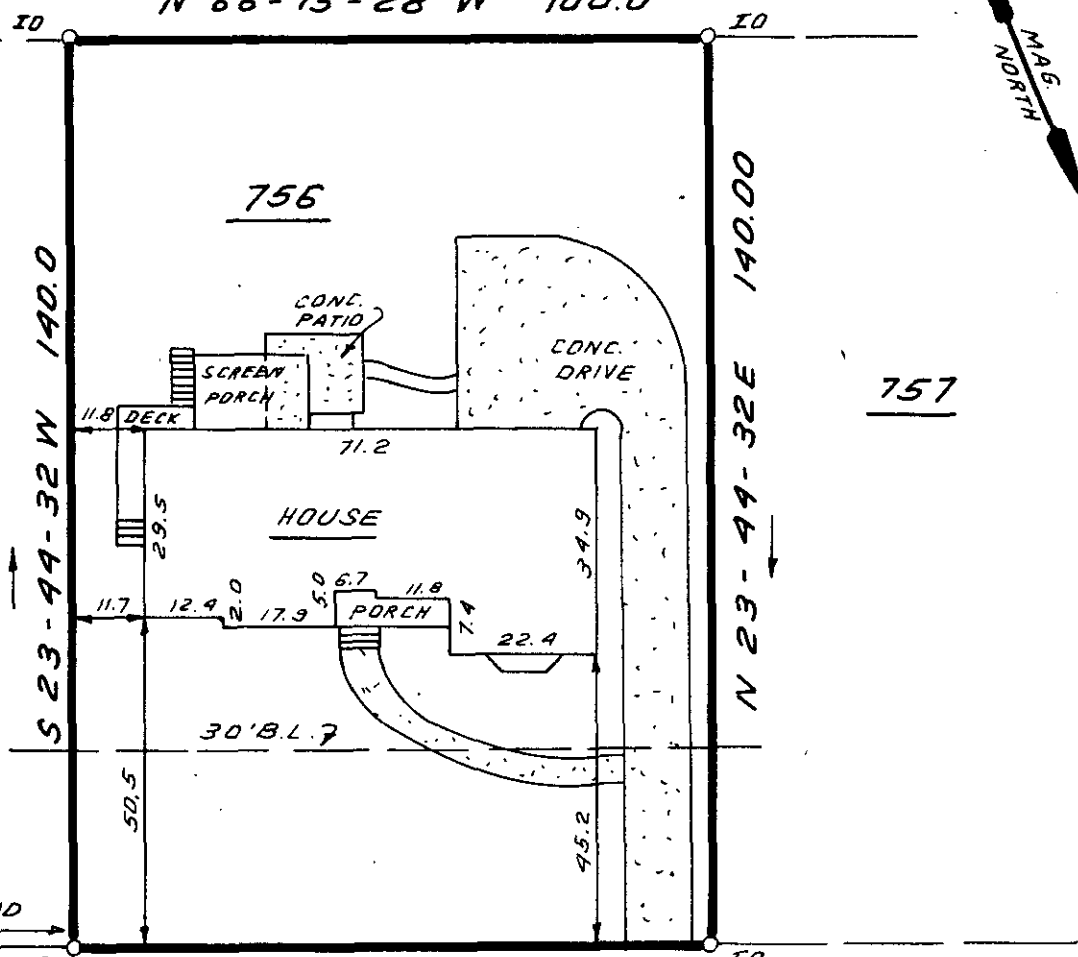

755

756

757

S 23-44-32 W 140.0

N 23-44-32 E 140.00

S 66-15-28 E 100.00

SOUTH WINGFIELD ROAD

608.42' ± TO STONECREST ROAD


24112

FILED  
GREENVILLE CO. S.C.  
FEB 15 12 37 PM 1985  
DONNIE S. TARKER  
R.M.C.

11-H-46



THIS IS TO CERTIFY THAT THE PROPERTY SHOWN ON THIS PLAT WAS SURVEYED UNDER MY DIRECT SUPERVISION AND THAT NO VISIBLE ENCROACHMENTS EXIST UNLESS OTHERWISE SHOWN. THIS PROPERTY IS NOT LOCATED IN A DESIGNATED FLOOD HAZARD AREA.

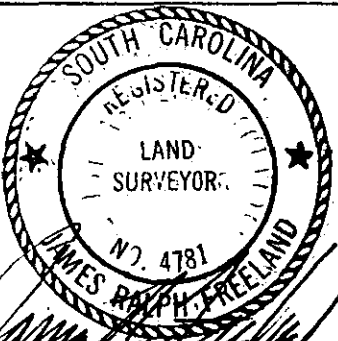

STATE OF SOUTH CAROLINA  
GREENVILLE COUNTY

FREELAND & ASSOCIATES  
Engineers • Land Surveyors  
318 WEST STONE AVENUE.  
GREENVILLE, S.C.  
(803) 271-4924

SUGAR CREEK  
MAP 2, SEC. 3, LOT 756  
PROPERTY OF  
JOHN W. ORR JR.  
BARBARA B. ORR

PLAT BOOK	9 W - 63
DEED BOOK	1221 - 556
TAX MAP	534.11-1-65
PARTY CHIEF	JEC
DRAWN	B.R.
DATE	2-14-85
DWG. NO.	12,461

RLS. JAMES R. FREELAND  
NO. 4781