MICROFILMED

FILED
GREENVILLE CO. S.C.
FEB 18 1 PM '85
DONNIE S. TANKERSLEY
R.M.C.

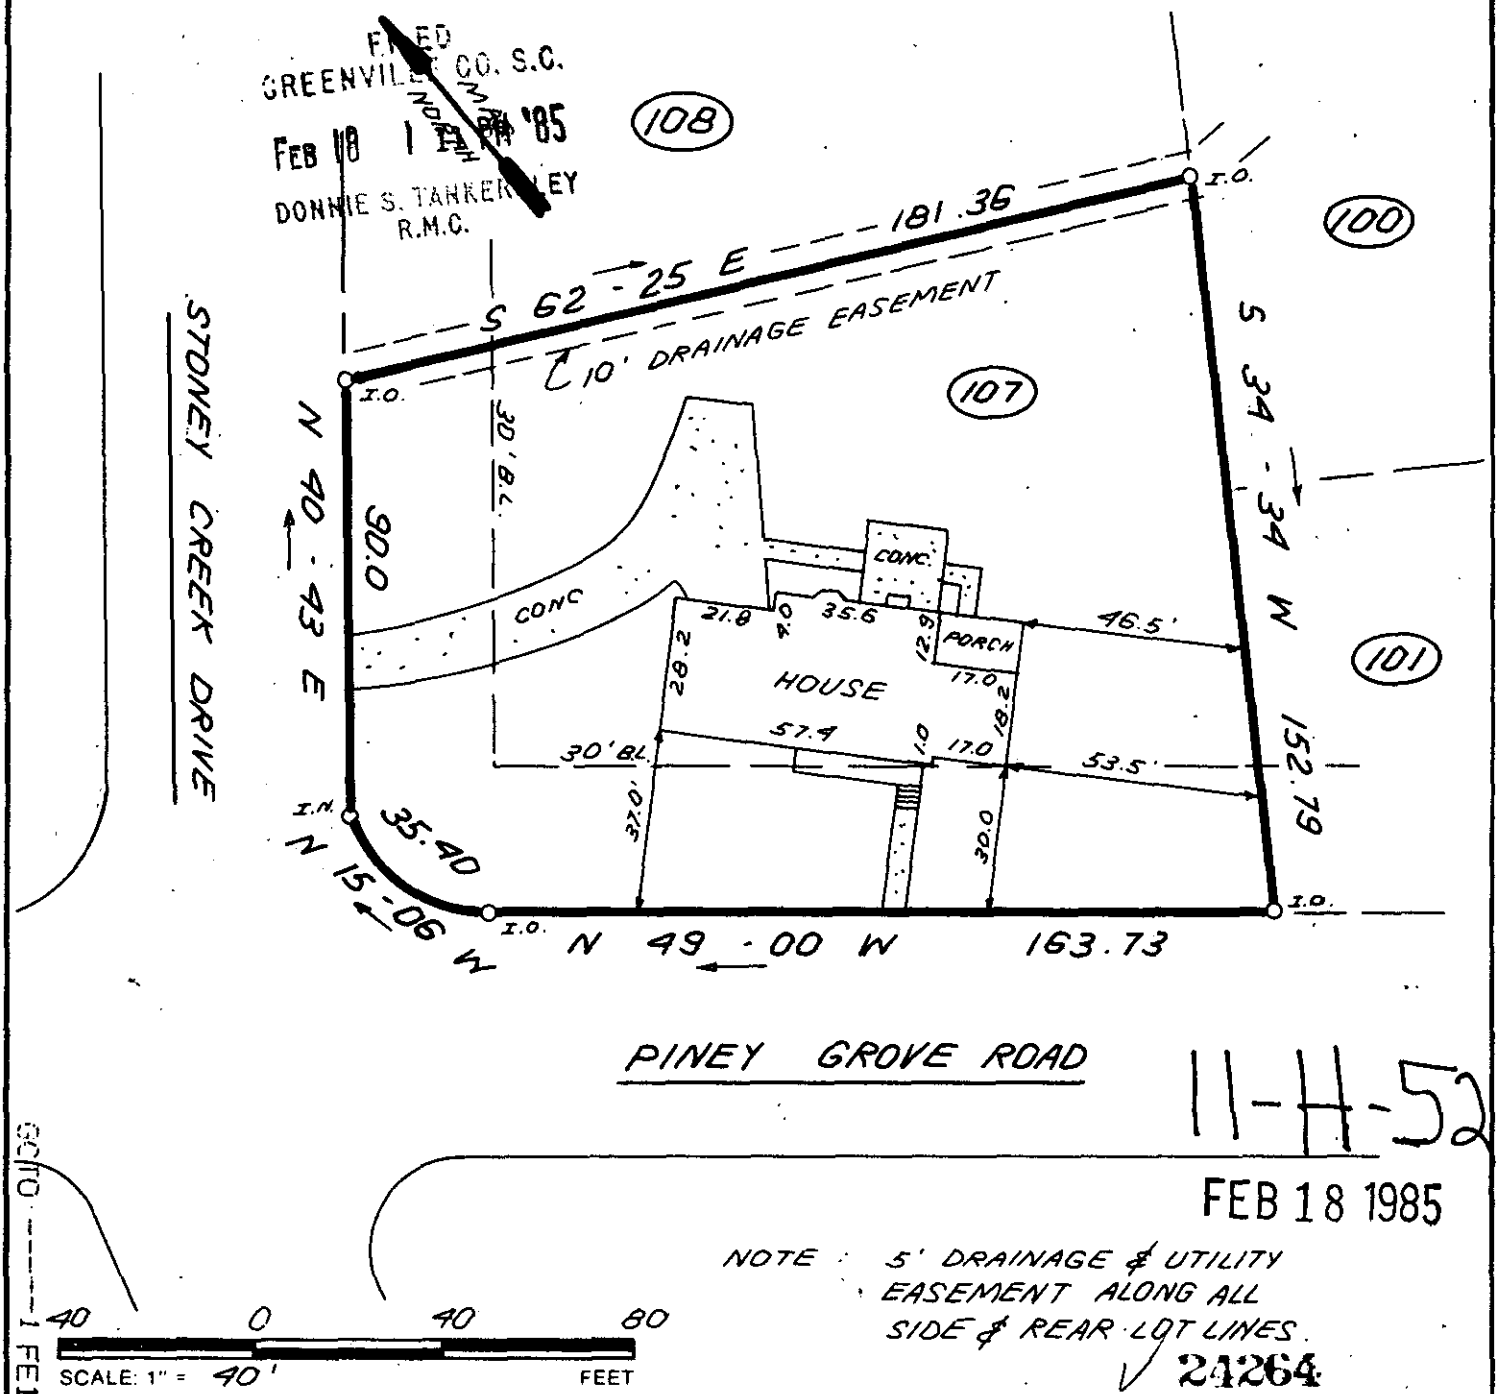

PINEY GROVE ROAD

11-H-52

FEB 18 1985

NOTE: 5' DRAINAGE & UTILITY EASEMENT ALONG ALL SIDE & REAR LOT LINES.

40 0 40 80
SCALE: 1" = 40' FEET

24264

THIS IS TO CERTIFY THAT THE PROPERTY SHOWN ON THIS PLAT WAS SURVEYED UNDER MY DIRECT SUPERVISION. PROPERTY LINES AND IMPROVEMENTS SHOWN ARE LOCATED CORRECTLY AND THAT NO VISIBLE ENCROACHMENTS EXIST UNLESS OTHERWISE SHOWN. THIS PROPERTY IS NOT LOCATED IN A DESIGNATED FLOOD HAZARD AREA.

SOUTH CAROLINA REGISTERED LAND SURVEYOR 4781

BY: JAMES A. FREELAND
BLS NO: 4781

STATE OF SOUTH CAROLINA
GREENVILLE COUNTY

FORRESTER WOODS
SEC. 7, LOT 107
PROPERTY OF
JAY A. BROERING &
MELISSA W. BROERING

FREELAND & ASSOCIATES
Engineers • Land Surveyors
318 WEST STONE AVENUE.
GREENVILLE, S.C.
(803) 271-4924

PLAT BOOK	5P @ 21
DEED BOOK	1115 - 761
TAX MAP	M 9.02 - 1 - 201
PARTY CHIEF	R.J.
DRAWN	K.E.G.
DATE	FEB 7, 1985
DWG. NO.	12427

THE PRINT MACHINE, INC. N53007