


MICROFILMED

FILED
GREENVILLE CO. S.C.

MAR 1 2 32 PM '85

DONNIE S. TANKERSLEY
R.M.G.

ASHMORE BRIDGE ROAD

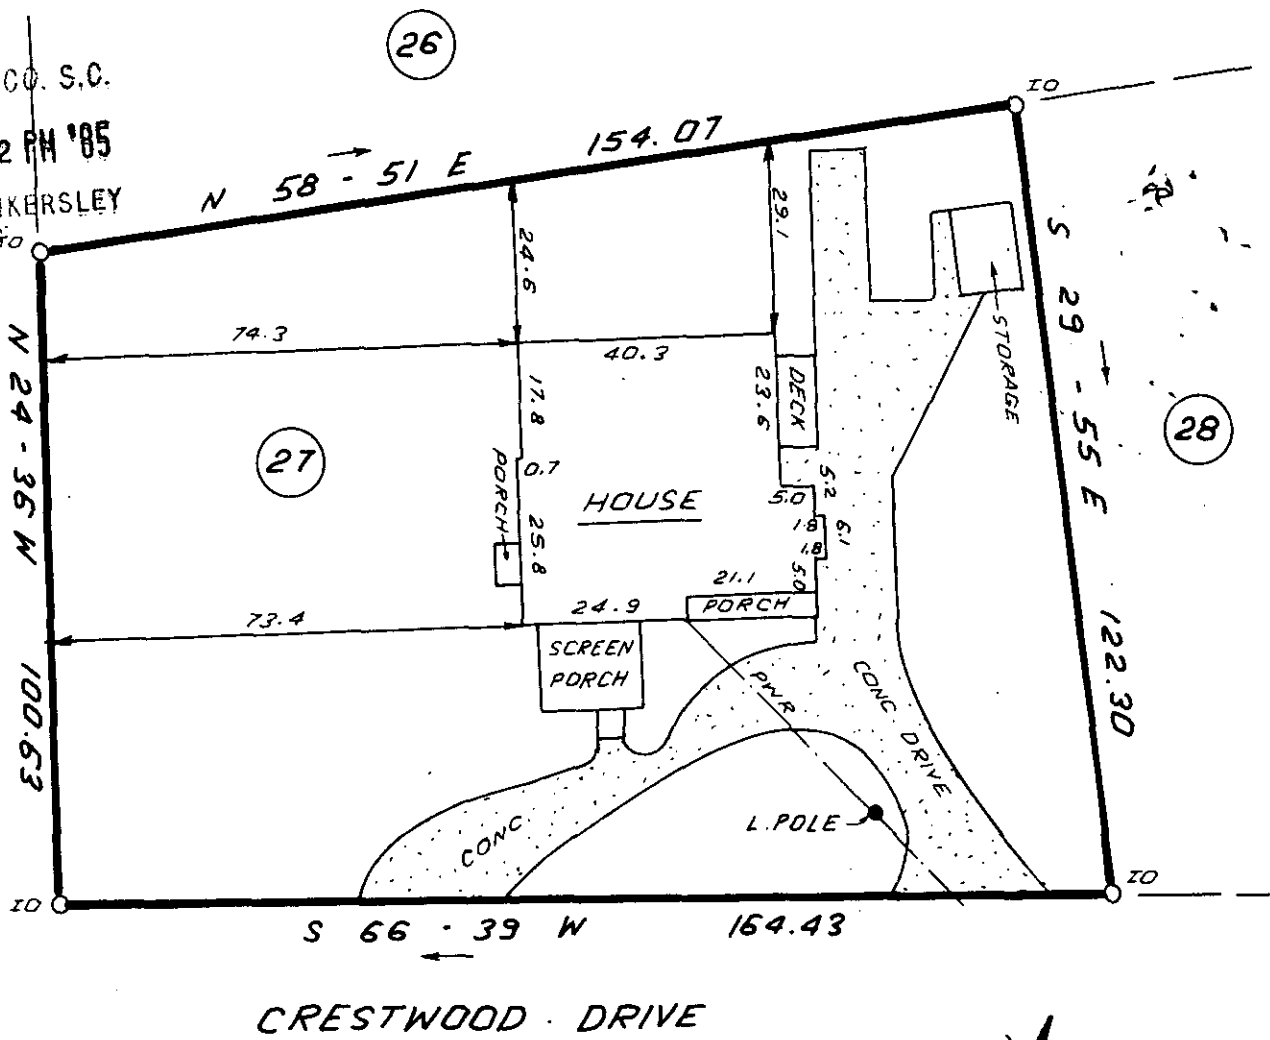

MAR 1 1985

MAG. NORTH
25647

11-A-95

30 0 30 60
SCALE: 1" = 30' FEET

THIS IS TO CERTIFY THAT THE PROPERTY SHOWN ON THIS PLAT WAS SURVEYED UNDER MY DIRECT SUPERVISION PROPERTY LINES AND IMPROVEMENTS SHOWN ARE LOCATED CORRECTLY AND THAT NO VISIBLE ENCROACHMENTS EXIST UNLESS OTHERWISE SHOWN. THIS PROPERTY IS NOT LOCATED IN A DESIGNATED FLOOD HAZARD AREA.

SOUTH CAROLINA
REGISTERED LAND SURVEYOR
4781
JAMES R. FREELAND

RLS: JAMES R. FREELAND
NO: 4781

STATE OF SOUTH CAROLINA
GREENVILLE COUNTY

MAULDIN HEIGHTS
LOT 27
PROPERTY OF
BOBBY E. DILLARD
BETH R. DILLARD

FREELAND & ASSOCIATES
Engineers • Land Surveyors
318 WEST STONE AVENUE,
GREENVILLE, S.C.
(803) 271-4924

PLAT BOOK	DD - 113A
DEED BOOK	
TAX MAP	M 6.2-1-40
PARTY CHIEF	J.C.
DRAWN	J.R. OCT 3, 1985
DATE	2-28-85
DWG NO.	12,544