

## DUKE POWER CO. R/W. (200' TOT.)

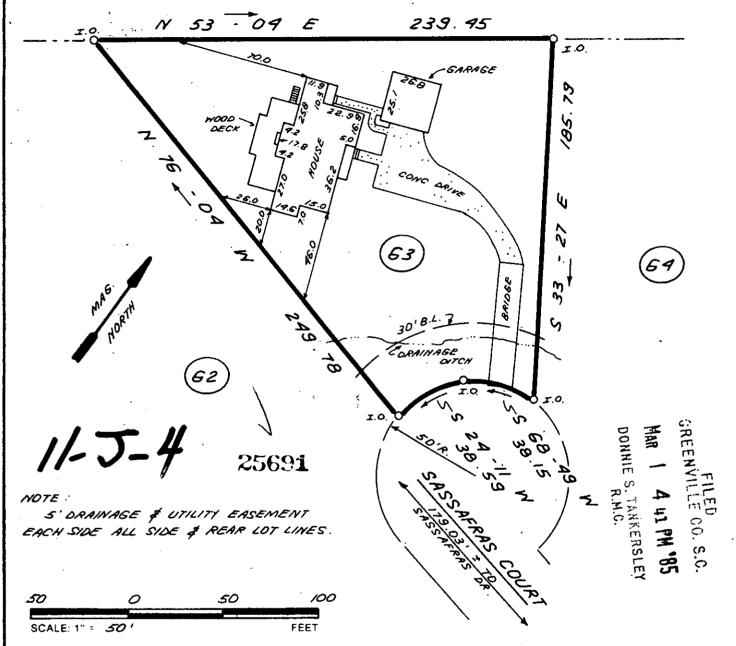

THIS IS TO CERTIFY THAT THE PROPERTY SHOWN ON THIS PLAT WAS SURVEYED UNDER MY DIRECT SUPERVISION. PROPERTY LINES AND IMPROVEMENTS SHOWN ARE LOCATED CORRECTLY AND THAT NO VISIBLE ENCROACHMENTS EXIST UNLESS OTHERWISE SHOWN. THIS PROPERTY IS NOT LOCATED IN A DESIGNATED FLOOD HAZARD AREA.

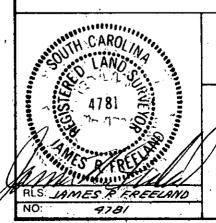

## STATE OF SOUTH CAROLINA GREENVILLE COUNTY

PEBBLECREEK

PHASE 1 , LOT 63

PROPERTY OF

GREGORY R. HAMILTON

MARGARET A. HAMILTON

## FREELAND & ASSOCIATES

Engineers • Land Surveyors ,318 WEST STONE AVENUE. GREENVILLE, S.C. (803) 271-4924

PLAT BOOK	5004
DEED BOOK	1199-429
TAX MAP 5	25.6 -/-63
PARTY CHIEF	B.G
DRAWN .	K.E.G.
DATE F2	EB: 26, 1985
DWG. NO.	12529