

N/F ROSE M. CUNNINGHAM ET. AL.

N 64° 35' E


GREENVILLE CO. S.C.

MAR 5 10 05 AM '85

DONNIE S. TANKERSLEY  
R.M.C.



SUNBELT PROPERTY

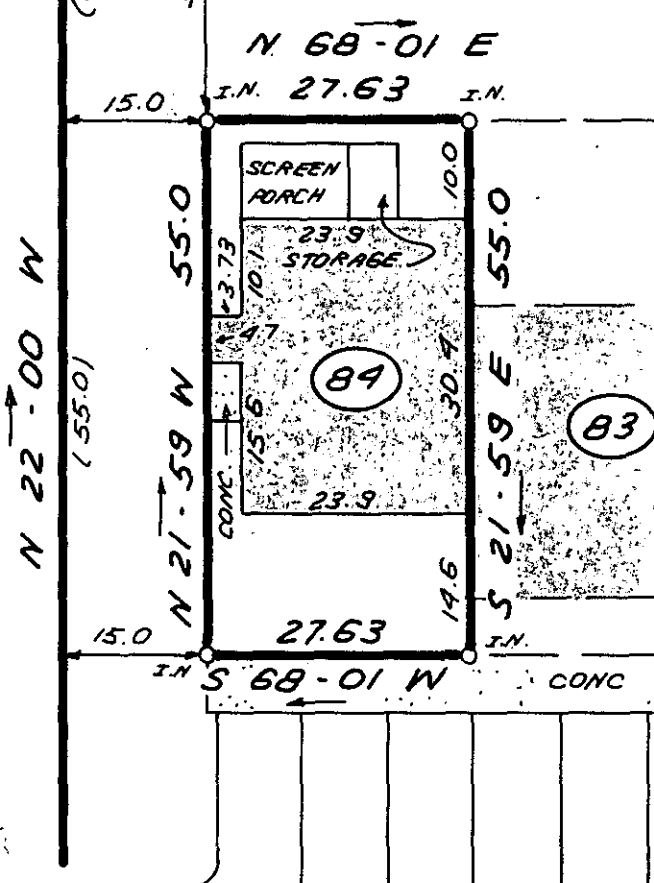

20 0 20 40  
SCALE: 1" = 20' FEET

11-5-14  
MAR 5 1985 26056

THIS IS TO CERTIFY THAT THE PROPERTY SHOWN ON THIS PLAT WAS SURVEYED UNDER MY DIRECT SUPERVISION. PROPERTY LINES AND IMPROVEMENTS SHOWN ARE LOCATED CORRECTLY AND THAT NO VISIBLE ENCROACHMENTS EXIST UNLESS OTHERWISE SHOWN. THIS PROPERTY IS NOT LOCATED IN A DESIGNATED FLOOD HAZARD AREA.



RLS: JAMES R. FREELAND  
NO: 4781

STATE OF SOUTH CAROLINA  
GREENVILLE COUNTY

JAMESTOWNE II  
UNIT 89  
PROPERTY OF  
JOHN C. JAMISON

FREELAND & ASSOCIATES  
Engineers • Land Surveyors  
318 WEST STONE AVENUE.  
GREENVILLE, S.C.  
(803) 271-4924

PLAT BOOK	JW - 33
DEED BOOK	
TAX MAP	
PARTY CHIEF	P.A.J.
DRAWN	K.E.G.
DATE	FEB. 22 1985
DWG. NO.	12509

5000 -- 3 MAR 05 85 15