MICROFILMED

FILED
GREENVILLE CO. S.C.
MAR 11 1 26 PM '85
DONNIE S. TANKERSLEY
R.H.C.

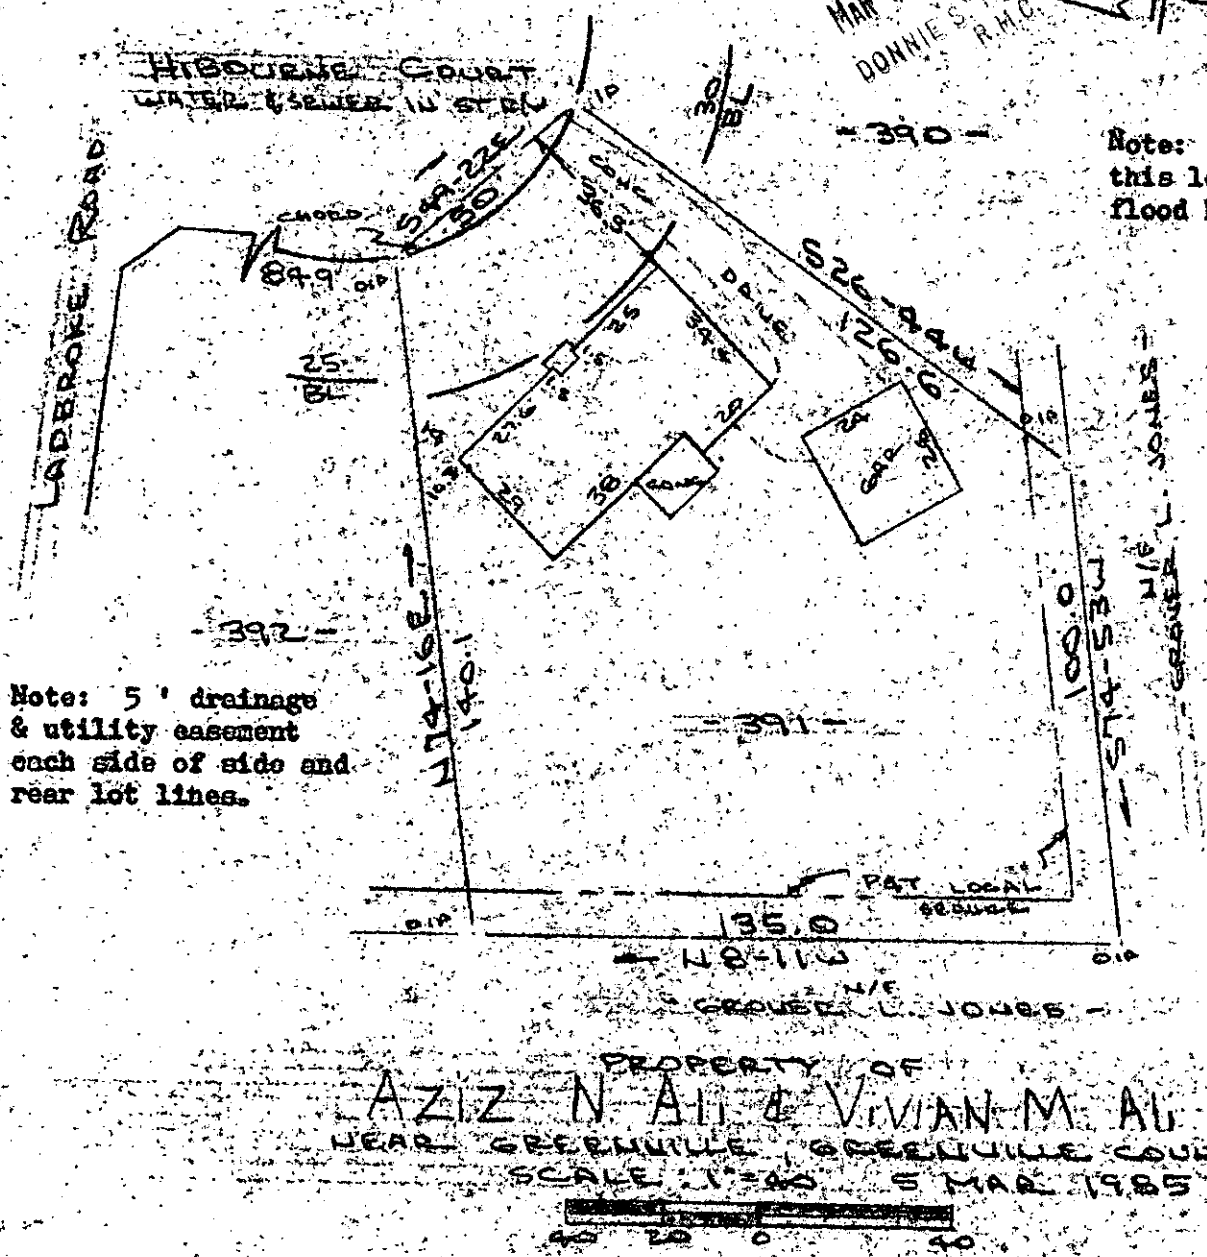

Note: Improvements on this lot are not in a flood hazard area.

Note: 5 ' drainage & utility easement each side of side and rear lot lines.

PROPERTY OF
AZIZ N ALI & VIVIAN M. ALI
NEAR GREENVILLE, GREENVILLE COUNTY, S.C.
SCALE 1"=40' 5 MAR 1985

This is to certify that on the 5th day of March, 1985, I surveyed the property shown on this plat, being known as lot 391 on plat of DEL NORTE ESTATES SECTION NO. III (Sheet No. 1) and recorded in the RMC Office Greenville County, S. C., in Plat Book " 4 - N " at Page 14; and that the property lines, walls and buildings are as shown hereon, and that the walls and buildings located on said lot do not encroach or project on adjacent or property, and that no adjacent walls or buildings encroach or project on said premises, and no power lines cross this property except as shown hereon. Also known as PROPERTY OF AZIZ N. ALI & VIVIAN M. ALI and recorded in Plat Book at Page .

MAR 11 1985

26629

11-J-33

R. B. Bruce

R. B. Bruce, RLS # 1952

SCT 3 MR 11 85 Recordable Plat

276/218

539.10-1-391